

CERTIFIED LAND CORNER RESTORATION

Index No. **P-9114**

State of Wisconsin

County of **Oneida**

ss.

I **Phillip T. Hansen**, do hereby certify that on the **10th** day of **December**, 1976, I found evidence of the **M.C. SW Cor. Gov. Lot 1** corner of **Section 24-19** Township **36** North, Range **10 - 11 East**, Fourth Principal Meridian,



as described hereon; and that from this evidence I established a new monument and accessories as described hereon to perpetuate the original location of this corner.

Resident witnesses.

Glen Barker

Jim Claffin

Herb Wagoner

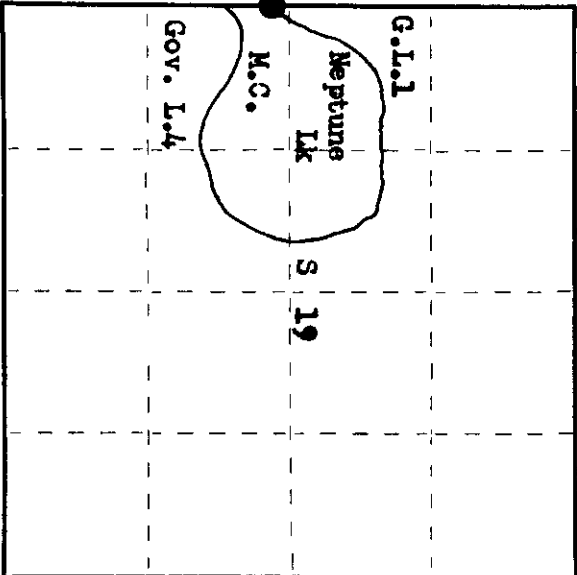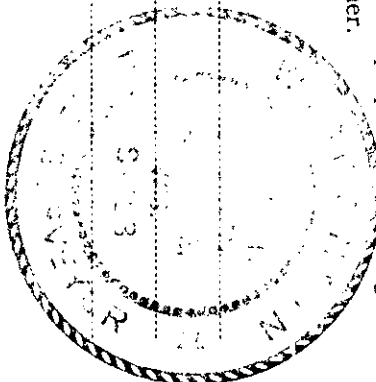

○ = Corner monument restored.

History of original corner establishment:

Corner established by Hiram C. Fellows, Deputy Surveyor, in 1859, from which tamarack 10" bears S 15° E 21 links and cedar 10" bears N 75° W 12 links. Corner recovered by D.H. Vaughan in 1900. Corner recovered by H.C. Lawrence, Registered Land Surveyor, in 1947. Recovered both of the original BTs and Vaughan's cedar post. The original notes calls for BTN75° W 12 links but found that it was S 71° W 12 links. Only rotted stump remains of tamarack S 15° E 21 links. NBT - Cedar 10" N 52° E 13 links.

Description of corner evidence found:

Recovered Lawrence's 5" cedar post, squared and scribed S19, R11E, S24 R10E M.C. T36N. Post was in poor condition. Also recovered a 2 1/2" iron pipe with brass cap (not stamped) setting beside it. Recovered OBT - Original Cedar 10" N 75° W 12 links, scribed T36N R10E, S24, now a 6' stub. (This was removed for display.) Cedar 10" N 52° E 13 links (now dead).

Description of monument and accessories I established to perpetuate the original location of this corner.

Removed Lawrence's post and 2 1/2" iron pipe from ground and set 2 1/2" iron pipe in hole of Lawrence's post. Cap stamped:
 NBT - Cedar 12" S 55° W 65.4 links
 Cedar 6" N 36° W 75.5 links, both scribed M.C. BT.
 Monument projects 2 1/2" above ground.
 Corner sets 1 chain west of west shore of Bug Lake (Neptune Lake).
 R 10 M.C. 24 19 11
 T36N R
 Gov. Lot 1
 CPI - 1976

Dated at **Rhineland**, Wis., this **15th** day of **December**, 1976

Signature: **Phillip T. Hansen** Title: **Registered Land Surveyor** Registration No. **S-498**
 (County Surveyor, Registered Land Surveyor, or other duly authorized official)

Office of Register of Deeds, County of **Oneida**, **7th** day of **February**, 1977
 at **1:45** o'clock **P.** M. I hereby certify that the within instrument was filed in this office for record on the

Karen Berger, Clerk
 (Register of Deeds)

By: **Joseph M. Boerner** Deputy

201041800