


CERTIFIED LAND CORNER RESTORATION

Index No. V-24


3610250010

State of Wisconsin } ss.
 County of Oneida

I Phillip T. Hansen, do hereby
 certify that on the 8th day
 of July, 1976, I found
 evidence of the E 1/16
 corner of Section 25 and 36
Township 36, North, Range
10 East, Fourth Principal Meridian,
 as described hereon; and that from this evidence
 I established a new monument and accessories
 as described hereon to perpetuate the original
 location of this corner.

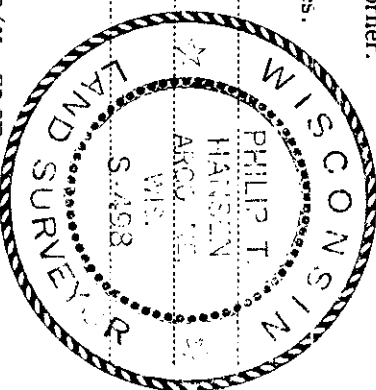

Resident witnesses:
Jim Claflin
Herb Wagoner

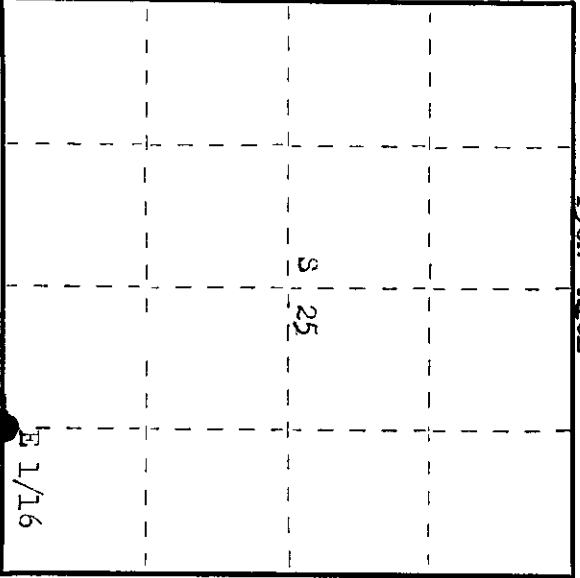

○ = Corner monument restored.

History of original corner establishment:

Corner established by D.H. Vaughan, County Surveyor, in 1905. Retraced by H.C. Lawrence, Registered Land Surveyor, in 1951. Recovered old post and BTs - white pine 16" S 78° E 19 lks and N. Pine 14" 14" S 47° " 24 lks.

Set new post and marked NBT - Spruce 9" S 77° W 27 lks.

Description of corner evidence found:

Recovered 4" squared cedar post in poor condition laying down under a windfall.

Recovered W. Pine stump 16" S 78° W 19 lks, Red Pine stump 14" S 47° W 24 lks, both stumps badly decomposed, but evidence of scribe marks visible. "Spruce 9" (14") S 77° W 27 lks. Our bearing S 87° W, scribed L 1/16 S36 NBT.

Recovered old hole for 4" stake from cross ties from recovered BTs.

Description of monument and accessories I established to perpetuate the original location of this corner.

Replaced Corner with 1 1/2" iron pipe with 2" brass cap stamped.

Monument projects 30" above ground.

NBT - Maple 8" S 9° E 9.0 lks, scribed 1/16 BT.
 Monument and BTs painted blue.
 3498
 T36N R10E
 S 1/16 S 25
 CRI-1976

Dated at Rhinelander, Wis. this 16th day of August, 1976

Signature: Phillip T. Hansen Title: Registered Land Surveyor Registration No. 3498
 County Surveyor, Registered Land Surveyor, or other duly authorized official

Office of Register of Deeds, County of Oneida. I hereby certify that the within instrument was filed in this office for record on the 22nd day of September, 1976 at 1:05 o'clock P. M.

Dona H. Stange Kuehn
 (Register of Deeds)

By: _____ Deputy