

CERTIFIED LAND CORNER RESTORATION

Index No. **V-23**



State of Wisconsin }
County of Oneida } ss.

I Philip T. Hansen, do hereby certify that on the 19th day of July, 1976, I found evidence of the quarter corner of Section 25-36 Township 36 North, Range 10 East, Fourth Principal Meridian, as described hereon; and that from this evidence I established a new monument and accessories as described hereon to perpetuate the original location of this corner.

Resident witnesses:

Jim Claffin

Herb Agoner

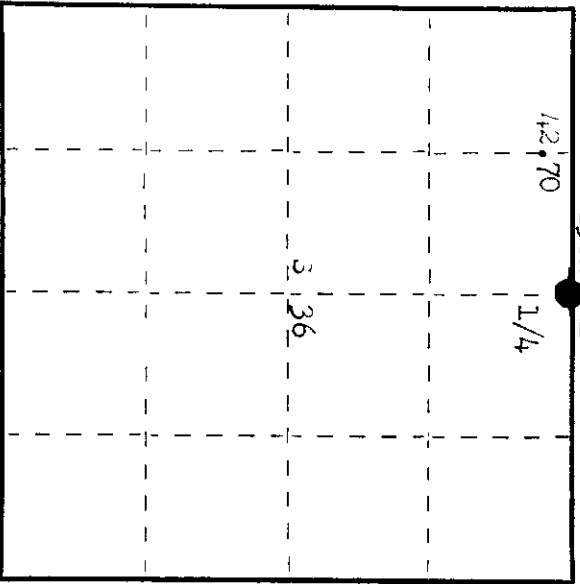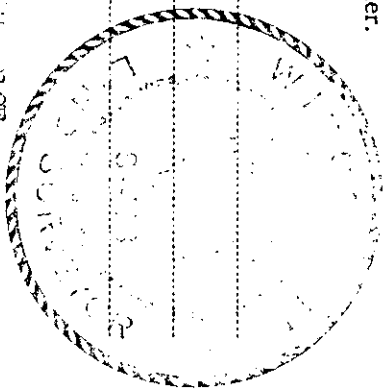

○ = Corner monument restored.

CERTIFIED LAND CORNER RESTORATION

Index No. **V-23**

History of original corner establishment: original corner established by Wm. W. Dougherty, Deputy Surveyor, in 1863, from which a pine 10" bears N 36° W 17 lks and birch 8" bears S 72° W 20 lks. Corner recovered by D.H. Vaughan, County Surveyor, in 1905. Claims to have found original trees. Set new post and made new bearing tree, white pine stp. 18" S 83° W 13-3/4 lks. H.C. Lawrence, Registered Land Surveyor, reset corner in 1950. Set post in line of fence running west where said fence intersects fence line running S 60° W, which is bearing of line between Sec. 25 and 26 east of 1/4 corner. marked NBU - Hi line pole N 3° W 46 1/2 lks. Hi Line S 55° W 45 1/2 lks.

Description of corner evidence found:
recovered 5" squared cedar post, scribed 1/4 S 25, 1/4 S 30 in poor condition.
Post was laying down next to hole, wired to fence post.
recovered UBU - Hi line pole N 3° W 40.5 lks (in 60° W)
Hi line pole S 55° W (S 30° W) 45.5 lks.
Poles were cut off flush with ground when all line removed.

Description of monument and accessories I established to perpetuate the original location of this corner.
replaced wood post with 2 1/2" Bernitsen #1 Federal monument, stamped.

monument projects .50" above ground.
NBTS - Red Pine S 69° W 52.7 lks, scribed 1/4 BT.
Red Pine 6" due south of 3.5 lks, scribed 1/4 BT.
Corner set in line on corner of Christmas tree plantation.
T36N R10E
1/4 S 25
3 36
3498-1976

Dated at Rhinelander, Wis., this 19th day of August, 1976.

Signature: *Philip T. Hansen* Title: Registered Land Surveyor Registration No. 3-498
(County Surveyor, Registered Land Surveyor or other duly authorized official)
Office of Register of Deeds, County of Oneida
Instrument was filed in this office for record on the 22nd day of September, 1976 at 1:00 o'clock P.M.

Signature: *Gene George Fisher*
(Register of Deeds)

By: _____ Deputy

3610250020