

CERTIFIED LAND CORNER RESTORATION

Index No. **S 9**

State of Wisconsin } ss.
 County of Oneida


I Philip T. Hansen, do hereby certify that on the 9th day of September 1975, I found evidence of the N-1/16 corner of Sections 28 and 29 Township 36 North, Range 10 East, Fourth Principal Meridian,

as described hereon; and that from this evidence I established a new monument and accessories as described hereon to perpetuate the original location of this corner.

Resident witnesses.

Glen Barker

Jim Claflin

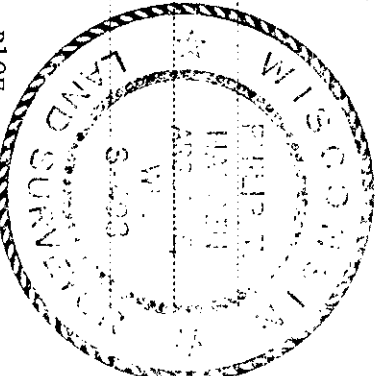


History of original corner establishment:
 Corner established by H.C. Lawrence, Registered Land Surveyor, in 1948. From the iron pipe set at section corners 20, 21, 28, and 29 determined from Dorr's BT's he ran South 42.32 chains to a point 37 links East of D.H. Vaughan's 1/4 corner. Found iron pipe and stump of original pine BT. Set a new post for N-1/16 corner at 21.16 chains equidistant and 18 1/2 links West. Marked NBT's cedar 14", N4°W, 55 links and cedar 6", S51 1/2°W, 26 links.

Description of corner evidence found:
 Recovered 5" cedar post, squared and scribed N-1/16 S28, N-1/16 S29, in fair condition.
 Recovered 55 links scribed N-1/16 BT
 Recovered 14" Cedar 14" N4°W 55 links
 Cedar 6" (7") S51 1/2°W (S55°W) 26 links (26.5 links) top scribing rotted out

Description of monument and accessories I established to perpetuate the original location of this corner.
 Replaced 5" cedar post with 1 1/2" OD iron pipe with 2" brass cap stamped - S498

NBT - Cedar 14" S5°W 35.6 links scribed 1/16 BT T36N, R10E

N-1/16 S29 S28
 CPI-1975

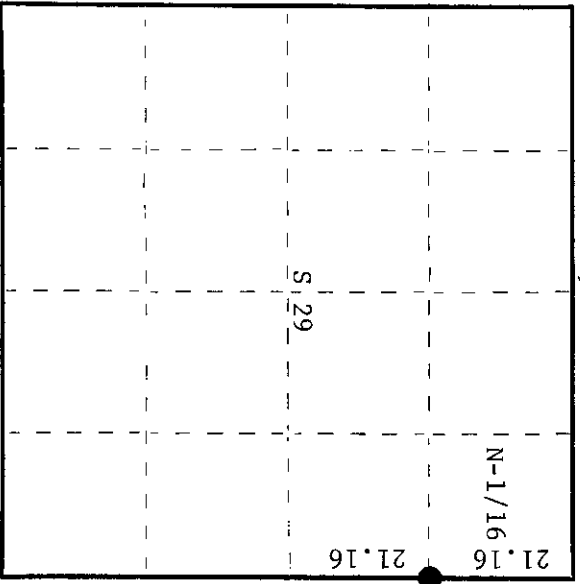

○ = Corner monument restored.

Dated at Rhinelander, Wis., this 19th day of September, 1975

Signature: *Philip T. Hansen* Title: Registered Land Surveyor Registration No. S-498
 (County Surveyor, Registered Land Surveyor, or other duly authorized official)

Office of Register of Deeds, County of Oneida
 Instrument was filed in this office for record on the 17th day of September, 1975 at 10:00 o'clock A.M.

Signature: *Dorcas Vernege Kuehni*
 (Register of Deeds)

By: _____ Deputy

0 0 0 2 9 3 3 6 1 0