

CERTIFIED LAND CORNER RESTORATION

Index No. V-4

History of original corner establishment:



H.C. Lawrence established corner in 1947. Old post bears S4-02-48E 8.36' of new established monument.

State of Wisconsin }  
County of Oneida } ss.

I Glen Barker do hereby certify that on the 13th day of June, 1984, I found ~~established~~ the E 1/16 corner of Sections 30 & 31 Township 36 North, Range 10 East, Fourth Principal Meridian, as described hereon; and that from this evidence I established a new monument and accessories as described hereon to perpetuate the original location of this corner.

Resident witnesses:

N. Spiess  
H. Wagoner

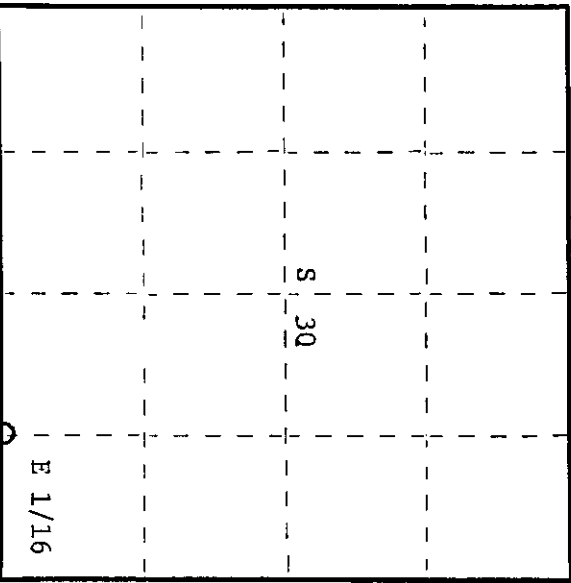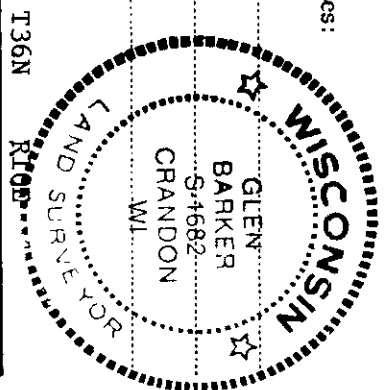

○ = Corner monument restored.

Description of corner evidence found:

Total distance from section corner 29-30-31-32 to 1/4 corner between sections 30 & 31 is 2447.02'.  
Set E 1/16 1223.50' intermediate.

Description of monument and accessories I established to perpetuate the original location of this corner.

Set a 1" iron pipe with 2" diameter alloy cap, stamped:  
Monument projects 18" above ground.  
Marked NBTs:

- Black Spruce 8" N3°W 5.74' T36N R10E S1682
- Black Spruce 5" N44E 13.84' E 1/16 S 30 S 31
- scribed 1/16-B.T. CPT-1984

Dated at Rhineland, Wis., this 8th day of August, 1984

Signature: *Glen Barker* Title: Registered Land Surveyor Registration No. S1682  
(County Surveyor, Registered Land Surveyor, or other duly authorized official)

Office of Register of Deeds, County of Oneida, I hereby certify that the within instrument was filed in this office for record on the 10th day of December, 1984 at 11:30 o'clock A.M.

Signature: *Donna George Fustler*  
(Register of Deeds)

By: \_\_\_\_\_ Deputy

3610300010