

CERTIFIED LAND CORNER RESTORATION

Index No. T-3

State of Wisconsin

County of Oneida } ss.

History of original corner establishment:



No evidence of any previous corner.

I, Glen Barker, do hereby certify that on the 12th day of June, 1984, I found evidence of the corner of Section 30, Township 36 North, Range 10 East, Fourth Principal Meridian, as described hereon; and that from this evidence I established a new monument and accessories as described hereon to perpetuate the original location of this corner.

Resident witnesses:

N. Spiess

H. Wagoner

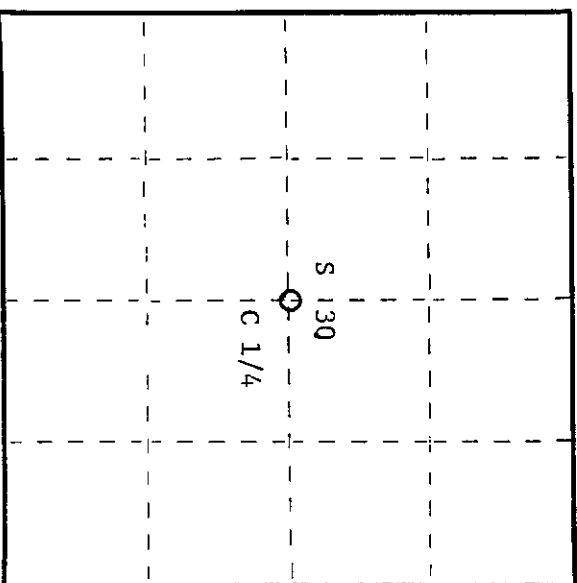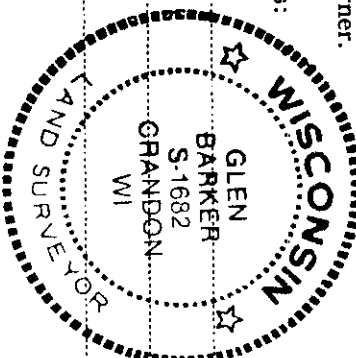

O = Corner monument restored.

Description of monument and accessories I established to perpetuate the original location of this corner.

Description of corner evidence found:

Corner established by subdivision of section 30.

- C 1/4 sets 2684.97' of N 1/4
2583.32' of E 1/4
2689.43' of S 1/4
2606.58' of W 1/4

Description of monument and accessories I established to perpetuate the original location of this corner.

Set a 2-1/2" aluminum pipe with alloy cap, stamped:

Monument projects 12" above ground.

- Marked NBTs:
White Birch 6" N37E 7.91'
Bl. Spruce 6" N27W 6.88'
Bl. Spruce 5" S46E 16.46'
scribed B.T.

T36N
S 130
R10E
S1682 - CPI - 1984

Dated at Rhineland, Wis., this 8th day of August, 1984

Signature: Glen Barker, Title: Registered Land Surveyor, Registration No. S1682

Office of Register of Deeds, County of Oneida. I hereby certify that the within instrument was filed in this office for record on the 10th day of December, 1984 at 11:30 o'clock a.m.

Debra Verage Kunkin, (Register of Deeds)

By: Deputy

3610 30 2020