

CERTIFIED LAND CORNER RESTORATION

Index No. X-21



State of Wisconsin

County of Oneida } ss.

I, Phillip T. Hansen, do hereby certify that on the 27th day of June, 1979, I found evidence of the Quarter corner of Sections 35 and 36 Township 36, North, Range 10 East, Fourth Principal Meridian, as described hereon; and that from this evidence I established a new monument and accessories as described hereon to perpetuate the original location of this corner.

Resident witnesses:

- Glen Barker
- Jim Claflin
- Herb Wagoner

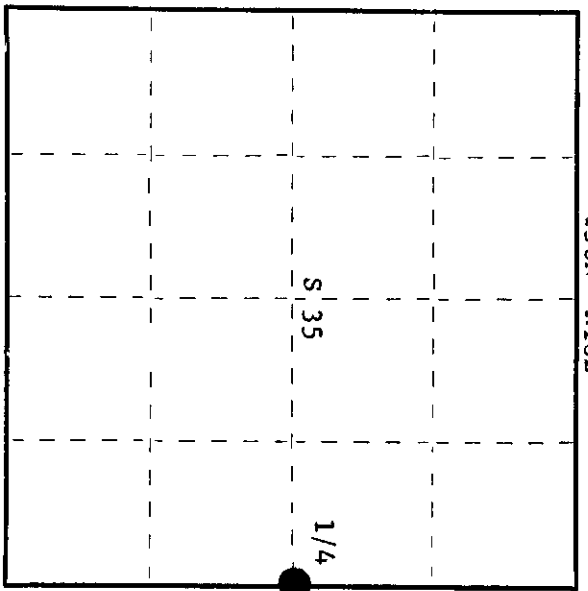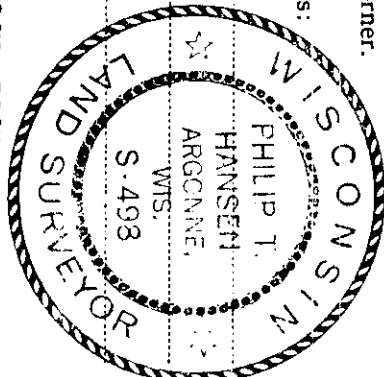

○ = Corner monument restored.

History of original corner establishment: Original corner established by Wm. E. Dougherty, Deputy Surveyor, in 1863, from which lind 10" bears S74°W 17 links; Fir 10" bears N55°E 25 links. Corner recovered by D.H. Vaughan, County surveyor, in 1905. Set new post and marked NBT's - Hemlock 10" N89-1/2°E 26 links; Linden 12" S20-1/2°W 17-1/2 links. H.C. Lawrence, Registered Land Surveyor, ran south of the section line in 1954, at Vaughan's recorded distance he recovered the hemlock BT and set a 5" cedar post in the hole of Vaughan's old stake. No evidence found of Linden BT.

Marked NBT's -

Hemlock 9" N88°W 35 links

Y. Birch 6" S34°E 19-1/2 links

Description of corner evidence found:

Recovered Lawrence's 5" cedar post, squared and scribed 1/4S-S35, 1/4S-S36, and a 2-1/2" iron pipe with brass cap, not stamped, setting beside it. This had been set by CPI foresters to perpetuate the corner.

Recovered OBT's -

Hemlock 9" (18") N88°W 35 links, scribing 1/4S visible.

W. Birch 6" S34°E 19-1/2 links, now down but scribe marks visible.

Description of monument and accessories I established to perpetuate the original location of this corner.

Left the iron pipe in place. Stamped cap -

Marked NBT's -

Sugar 7" S12°E 47.1 links, scribed 1/4 BT.

Sugar 8" S39°W 23.4 links, scribed 1/4 BT.

Sugar 8" S86°E 56.1 links, scribed 1/4 BT.

S498
T36N R10E
S 35
1/4
CPI-1979

Dated at Rhinelander, Wis., this 10th day of July, 1979.

Signature Phillip T. Hansen Title Registered Land Surveyor Registration No. S-498
(County Surveyor, Registered Land Surveyor, or other duly authorized official)

Office of Register of Deeds, County of Oneida I hereby certify that the within instrument was filed in this office for record on the 7th day of August, 1979 at 1:00 o'clock P. M.

Doris Verage Krehan
(Register of Deeds)

By: _____ Deputy

3610352000