

CERTIFIED LAND CORNER RESTORATION



Index No. **E-21**

State of Wisconsin

County of Oneida } ss.

I Philip T. Hansen do hereby certify that on the 3rd day of December, 1974, I found evidence of the S1 S2-S11-S12 corner of S1 Township 36 N11 East, Fourth Principal Meridian, as described hereon; and that from this evidence I established a new monument and accessories as described hereon to perpetuate the original location of this corner.

Resident witnesses:

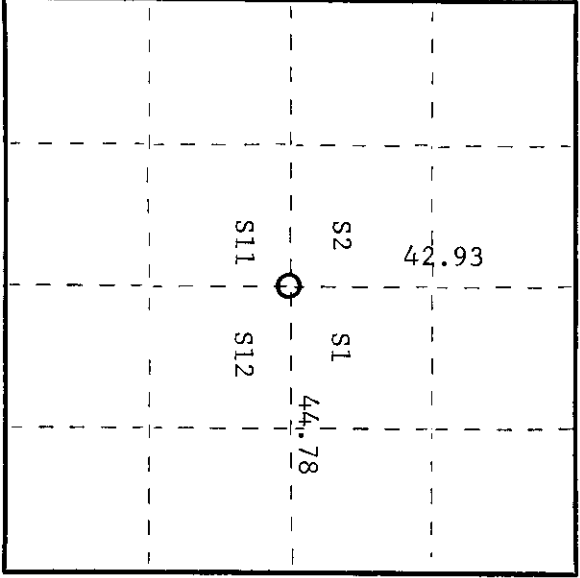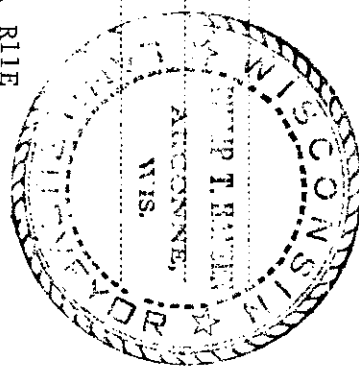

○ = Corner monument restored.

History of original corner establishment:

Original survey established by Wm. E. Dougherty, Gov't Deputy Surveyor in 1859. Re-survey made by B.F. Dorr, County Surveyor in 1898. Dorr's note states that he found the original BT's at this corner at 42.96 chains South of 1/4 corner. No mention of new corner or new bearing trees.

H.C. Lawrence's retracement survey of 1957 states he recovered the West 1/4 corner and ran due South 42.93 chains at which point he recovered an old downed squared hemlock and a very old line of blazes running East. Old squared downed hemlock believed to have been squared for corner when it was standing.

Lawrence set new post but made no mention of bearing trees. Description of corner evidence found:

Recovered H.C. Lawrence's 4" cedar post set in 1957, squared and scribed S1, S2, S11, S12 in fair condition wired to a 1" iron pipe.

No old bearing trees visible.

Description of monument and accessories I established to perpetuate the original location of this corner.

Set new 2-1/2" x 5' galvanized iron pipe with brass cap stamped as follows -

New BT's Sugar maple 11" N53°W 8 lks. scribed S BT T36N, R11E
Sugar maple 7" S70°W 21 lks. scribed S BT S498

S2 | S1
S11 | S12

CPT-1974

Dated at Rhinelander, Wis., this 16th day of June, 1975

Signature: *Philip T. Hansen* Title: Registered Land Surveyor Registration No. S-498
(County Surveyor, Registered Land Surveyor, or other duly authorized official)

Office of Register of Deeds, County of Oneida, I hereby certify that the within instrument was filed in this office for record on the 1st day of October, 1975 at 3:00 o'clock P.M.

Doris Verage Fuchs
(Register of Deeds)

By: Deputy

3611020000