

CERTIFIED LAND CORNER RESTORATION



Index No. **E-20**

State of Wisconsin

County of Oneida } ss.

I, Phillip T. Hansen, do hereby certify that on the 9th day of January, 1975, I found evidence of the E-1/16 corner of Sections 2 and 11 Township 36 North, Range 11 East, Fourth Principal Meridian, as described hereon; and that from this evidence I established a new monument and accessories as described hereon to perpetuate the original location of this corner.

Resident witnesses:

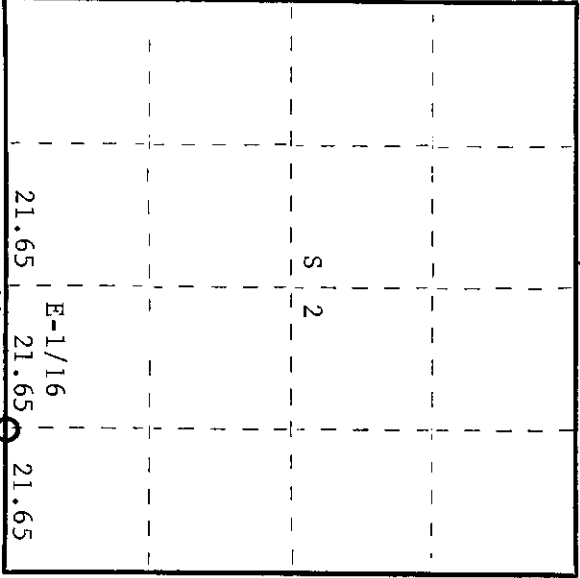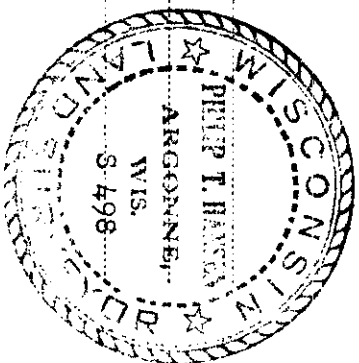

○ = Corner monument restored.

History of original corner establishment:

No record available of this corner having been established prior to H.C. Lawrence's re-
 tracement survey of 1957. His notes state that he established line between Sections 2 and
 11 by running a random line East magnetic from B.F. Dorr's 1/4 Corner between Sections 3 and
 10 to Dorr's section corner 2-1-11-12, intersected at point 6.74 chains North of the corner.
 Lawrence's corner of 3-2-10-11 was established 58 lks. South and 2.07 chains East of the
 N-S E-W random line to have length of line between 2 and 3 conform to old E-W 1/4 line across
 Sec. 2 to fit state timber. Corrected distance between S2-11 82.60 chains. Departure 6.16
 chains. Corrected bearing S85°45'E. He set E-1/16 corner on true line 5.20 chains South
 of random at 61.95 chains. Set new 6" cedar post. No mention of BT's.

Description of corner evidence found:

Recovered 6" cedar post, squared and scribed E-1/16 S2 E-1/16 S11 in fair condition.

No BT's visible.

Description of monument and accessories I established to perpetuate the original location of this corner.

Set 1" x 5" iron pipe with 2" brass cap stamped as follows -

- Red pine 5" N22°W 17-2/3 lks. Scribed 1/16 BT S 2
- Red pine 5" S2°W 3 lks. Scribed 1/16 BT E-1/16 —
- Red pine 5" N56°E 11 lks. Scribed 1/16 BT S 11

S498
 T36N, R11E

CPT-1975

Dated at Rhineland, Wis., this 16th day of June, 1975.

Signature: *Phillip T. Hansen* Title: Registered Land Surveyor Registration No. S-498
 (County Surveyor, Registered Land Surveyor, or other duly authorized official)

Office of Register of Deeds, County of Oneida
 Instrument was filed in this office for record on the 1st day of October, 1975 at 3:00 o'clock P.M.

Doris Verage Fuchler
 (Register of Deeds)

By: Deputy

3611020010