


CERTIFIED LAND CORNER RESTORATION

State of Wisconsin

County of Oneida } ss.

I, Philip T. Hansen, do hereby certify that on the 23rd day of January, 1975, I found evidence of the W-1/16 corner of Section 2 and 11 Township 36 North, Range 11 E, Fourth Principal Meridian, as described hereon; and that from this evidence I established a new monument and accessories as described hereon to perpetuate the original location of this corner.

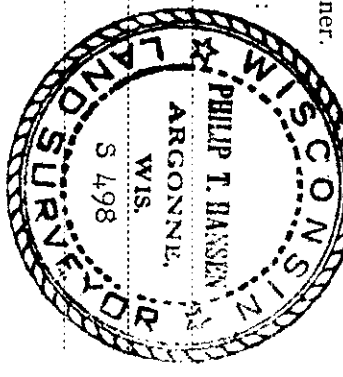

Resident witnesses:

History of original corner establishment: Corner established by H.C. Lawrence, Registered Land Surveyor, during his retracement survey and subdivision of Section 2 in 1953.

Set W-1/16 corner equidistant between Section Corner 2,3,10 and 11, and the S-1/4 corner between Section 2 and 11 at 20.65 chains.

Set 4" cedar post.

Nothing suitable for Br's.

Description of corner evidence found: Recovered 4" cedar post, squared and scribed S2 W-1/16, S11 W-1/16 in fair condition.


No bearing trees recovered.

Description of monument and accessories I established to perpetuate the original location of this corner.

Replaced wooden post with 1-1/4"OD x 5' galvanized iron pipe w/brass cap stamped -

- NBT's - Black spruce 8" N84°W 27.5 links scribed 1/16 BT
- Black spruce 6" S58E 37.5 links scribed 1/16 BT
- W-1/16 S2 S11

CPT-1975

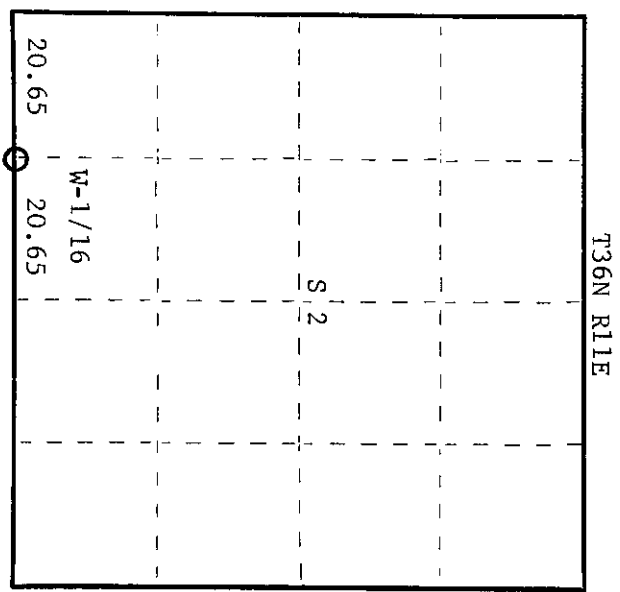

O = Corner monument restored.

Dated at Rhineland, Wis., this 16th day of June, 1975.

Signature Philip T. Hansen Title Registered Land Surveyor Registration No. S-498
(County Surveyor, Registered Land Surveyor, or other duly authorized official)

Office of Register of Deeds, County of Oneida. I hereby certify that the within instrument was filed in this office for record on the 1st day of October, 1975 at 3:00 o'clock P.M.

Signature Doris George Fuchs
(Register of Deeds)

By: Deputy

36 11020030