

CERTIFIED LAND CORNER RESTORATION

Index No. C-9



State of Wisconsin

County of Oneida } ss.

I, Philip T. Hansen, do hereby certify that on the 1st day of June, 1979, I found evidence of the Quarter corner of Sections 4 and 5 Township 36 North, Range 11 East, Fourth Principal Meridian, as described herein; and that from this evidence I established a new monument and accessories as described hereon to perpetuate the original location of this corner.

Resident witnesses

Jim Clafflin
Herb Wagoner

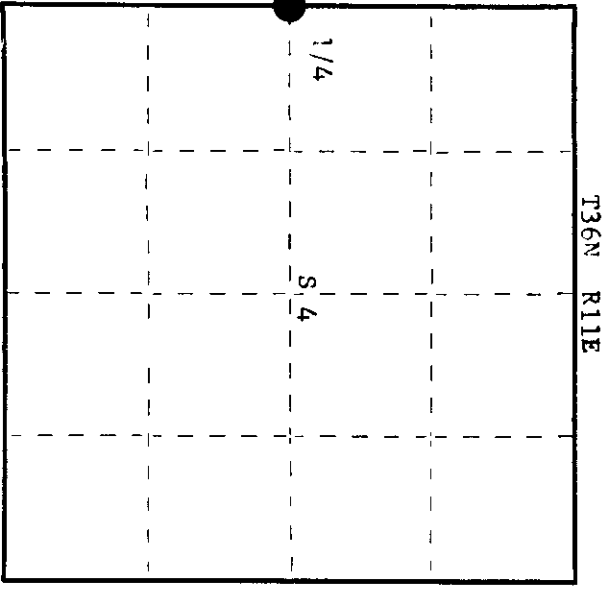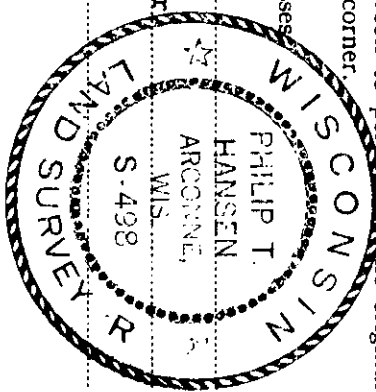

○ = Corner monument restored.

History of original corner establishment:

Original corner established by Wm. E. Dougherty, Deputy Surveyor, in 1859, from which W. Birch 12" bears N17°W 24 links and Aspen 10" bears S56°E 31 links. Corner recovered by D.H. Vaughan, County surveyor, in 1907. Marked W. Pine 5" N18°E 30 links and telephone pole 10" S77-1/2°W 30 links. Corner recovered by V.M. Maine, County surveyor. He set an iron pipe and marked a white pine 16" S18°E 72-1/2 links.

Description of corner evidence found:

Recovered Maine's 2-1/2" iron pipe with brass cap, not stamped, leaning badly. Recovered Maine's old BT - W. Pine 16" (18") S18°E 72.5 links, our bearing S 15° E, scribbed 1/4 S4 BT. No evidence of Vaughan's OBT.

Description of monument and accessories I established to perpetuate the original location of this corner.

Reset Maine's iron monument in old hole. Piled a cairn of rocks around the base. Monument projects 3' above ground. Cap was stamped:
Marked NBT's - S498
Tamarack 6" N16°E 58.8 links
B. Spruce 10" N59°E 36.7 links
Maple 5" S44°E 61.1 links
all scribbed 1/4 BT. CPI-1979

Dated at Rhineland, Wis. this 12th day of June, 1979

Signature Philip T. Hansen Title Registered Land Surveyor Registration No. S-498
(County Surveyor, Registered Land Surveyor, or other duly authorized official)

Office of Register of Deeds, County of Oneida. I hereby certify that the within instrument was filed in this office for record on the 7th day of August, 1979 at 1:00 o'clock P.M.

Donna M. Hagg
(Register of Deeds)

By _____ Deputy

0002501192