

CERTIFIED LAND CORNER RESTORATION

Index No. C-8

State of Wisconsin


County of Oneida } ss.

I, Phillip T. Hansen, do hereby certify that on the 9th day of January, 1979, I found evidence of the EC 1/16 corner of Section 5 Township 36 North, Range 11 East, Fourth Principal Meridian, as described hereon; and that from this evidence I established a new monument and accessories as described hereon to perpetuate the original location of this corner.


Resident witnesses:

Jim Clafflin

Herb Wagoner

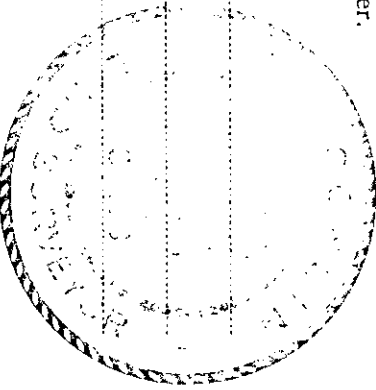

T36N R11E

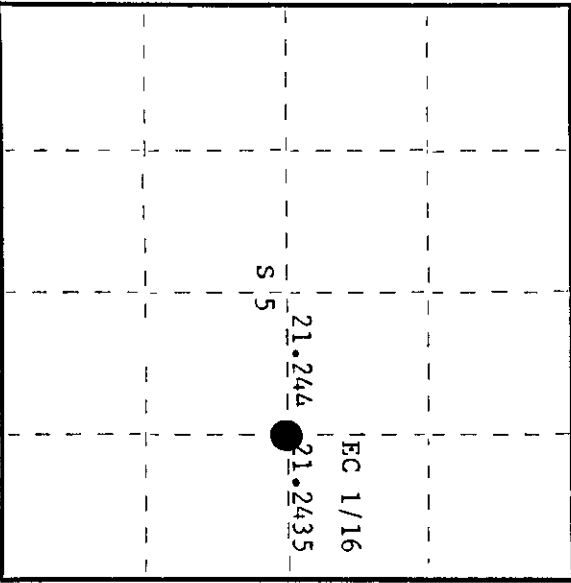

○ = Corner monument restored.

History of original corner establishment:

Corner established by Loftus and crew, Ripco surveyors, in 1962. Ran N-S and E-W 1/4 lines to establish C 1/4 corner. Set C 1/4 corner at 41.92 chains east of west 1/4 corner at corrected bearing S 88° 47' E. Set EC 1/16 corner at 63.164 chains intermediate between C 1/4 and E 1/4 corner. Marked NBT's -
Birch 5" N24°W 24 links
Maple 3" S46°E 38 links

Description of corner evidence found:

Recovered 3/4" iron pipe with 2" diameter brass cap in excellent condition. Monument projects 18" above ground. Cap stamped:
Recovered OBT's -
W. Birch 5" (8") N24°W (N18°W) 24 links
Maple 3" (6") S46°E (S41°E) 38.5 links
scribing grown over.

CE 1/16
S5
RIPCO

Description of monument and accessories I established to perpetuate the original location of this corner. Monument left in place as recovered. No additional accessories established.

Dated at Rhinelander, Wis., this 10th day of January, 1979

Signature: Phillip T. Hansen Title: Registered Land Surveyor Registration No. S-498
(County Surveyor, Registered Land Surveyor, or other duly authorized official)

Office of Register of Deeds, County of Oneida. I hereby certify that the within instrument was filed in this office for record on the 25th day of January, 1979 at 11:5 o'clock A. M.

Doris Verage Hansen
(Register of Deeds)

By: _____ Deputy