

CERTIFIED LAND CORNER RESTORATION

Index No. C-7

State of Wisconsin

County of Oneida } ss.

I Phillip T. Hansen, do hereby

certify that on the 1st day

of June, 1979, I found

evidence of the C 1/4

corner of Section 5

Township 36, North, Range

11 East, Fourth Principal Meridian,


as described hereon; and that from this evidence

I established a new monument and accessories

as described hereon to perpetuate the original

location of this corner.


T36N R11E

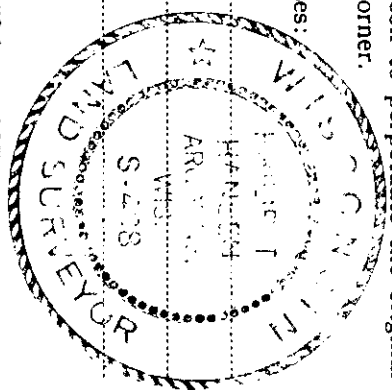

Resident witnesses:

Jim Claflin

Herb Wagoner

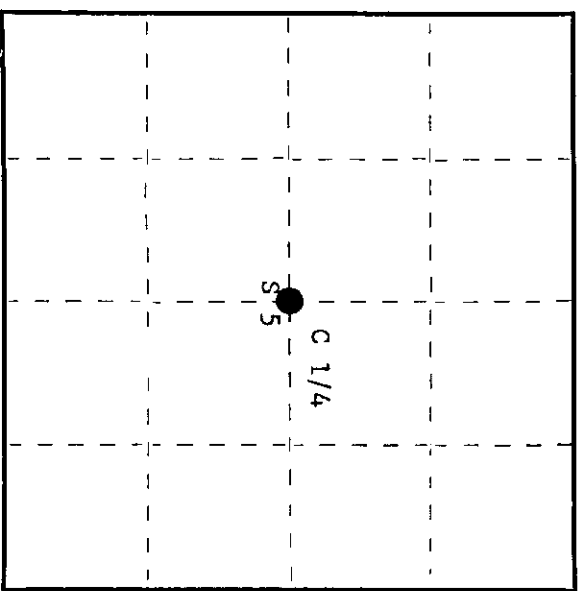

○ = Corner monument restored.

History of original corner establishment:

Corner established by N. Loftus, Ripco surveyor, in 1962.

Corner established at 41.92 chains south 88° 47' E of N 1/4 corner.

Set iron post and marked NBT's -

Birch 4" N30°W 44 links

W.Spruce 2" N35°E 60-1/2 links.

Description of corner evidence found:

Recovered the 2" iron pipe bent over badly from timber cutting operations.

Recovered stump of W.Birch 4" N30°W 44.0 links (44.5 links) and W.Spruce 2" N35°E,

60.5 links (60.0 links), now a cut off stump.

Description of monument and accessories I established to perpetuate the original location of this corner.

Removed Ripco's bent monument and replaced it with 2-1/2" Bernitsen A-1 Federal Monument.

Monument projects 18" above ground. Cap stamped:

Marked NBT's -

W.Spruce 5" N38°W 58.1 links

W.Spruce 5" N11°E 50.4 links

both scribed C 1/4 BT.

T36N R11E

C 1/4 S+5

S498 - 1979

Dated at Rhineland, Wis., this 12th day of June, 1979

Signature Phillip T. Hansen Title Registered Land Surveyor Registration No. S-498

County Surveyor, Registered Land Surveyor, or other duly authorized official)

Office of Register of Deeds, County of Oneida 7th day of June, 1979

at 1:00 o'clock P.M. I hereby certify that the within

instrument was filed in this office for record on the 7th day of June, 1979

By Phillip T. Hansen (Register of Deeds) Deputy

3611052020