

CERTIFIED LAND CORNER RESTORATION

Index No. **C-3**

State of Wisconsin



County of Oneida } ss.

I Phillip T. Hansen, do hereby certify that on the 5th day of May, 1975, I found evidence of the C-1/4 corner of Section 6

Township 36, North, Range 11 East, Fourth Principal Meridian,

as described hereon; and that from this evidence I established a new monument and accessories as described hereon to perpetuate the original location of this corner.

Resident witnesses:

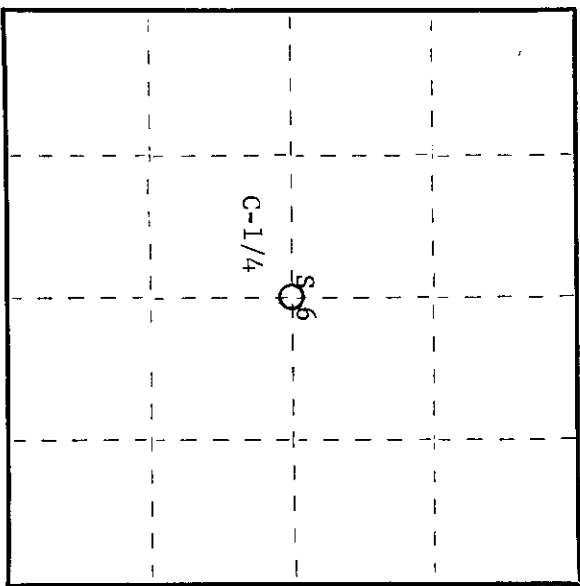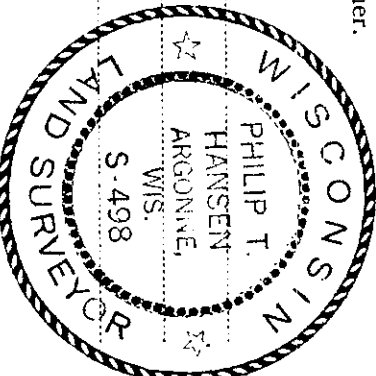

○ = Corner monument restored.

History of original corner establishment:

Original corner established by B.F. Dorr, County Surveyor, in 1888 from which tamarack 10" bears S22°W, 20-1/2 links, pine 7" bears S40-1/2°E, 8 links. Corner recovered by H.C. Lawrence in 1947. He found stumps of Dorr's BT's. And also the point of Dorr's stake. He found that Dorr had misread his bearing to the tamarack BT. Checking further, he observed that instead of S22°W, he should have recorded S67°W. Vaughan had found this corner and used it in 1906 but made no mention of an error at that time.

Lawrence made NBT's: White birch 5" S4-1/2°E 52 links
White birch 7" N79°W 89-1/2 links.

Description of corner evidence found:

Recovered H.C. Lawrence's 6" cedar post, squared and scribed C-1/4S S6, C-1/4S S6 in poor condition, broken off, and lying on ground. A 1-1/2" iron pipe and an iron pin were also found.

Recovered OPT's: White birch 7" N79°W 89-1/2 links (now a 4' stub) scribed C-1/4 NBT Pine 12" S41°E 8 links (stump - Dorr's) axe marks and some scribing.

Recovered 3" cedar post, squared one side, scribed BT set up by pine stump.

Description of monument and accessories I established to perpetuate the original location of this corner.

Replaced old stakes and iron pipe with 2-1/2" iron pipe w/brass cap stamped - S498 T36N R11E

NBT's: White spruce 6" S67°E 32.2 links scribed 1/4 BT
White spruce 6" S19°W 49.3 links scribed 1/4 BT. C-1/4 S/6 CPT-1975

Dated at Rhineland, Wis., this 1st day of July, 1975.

Signature Phillip T. Hansen Title Registered Land Surveyor Registration No. S-498
(County Surveyor, Registered Land Surveyor, or other duly authorized official)

Office of Register of Deeds, County of Oneida at 1st day of October, 1975
at 3:00 o'clock P. M. I hereby certify that the within

Donna Savage Fischer
(Register of Deeds)

By: _____ Deputy

3611062020