

CERTIFIED LAND CORNER RESTORATION

Index No. J-3

State of Wisconsin



County of Oneida } ss.

I Philip T. Hansen do hereby certify that on the 13th day of April, 1979, I found evidence of the Quarter corner of Section 7 & 18 Township 36 North, Range 11 East, Fourth Principal Meridian, as described hereon; and that from this evidence I established a new monument and accessories as described hereon to perpetuate the original location of this corner.

Resident witnesses:

Jim Clafflin

Herb Wagoner

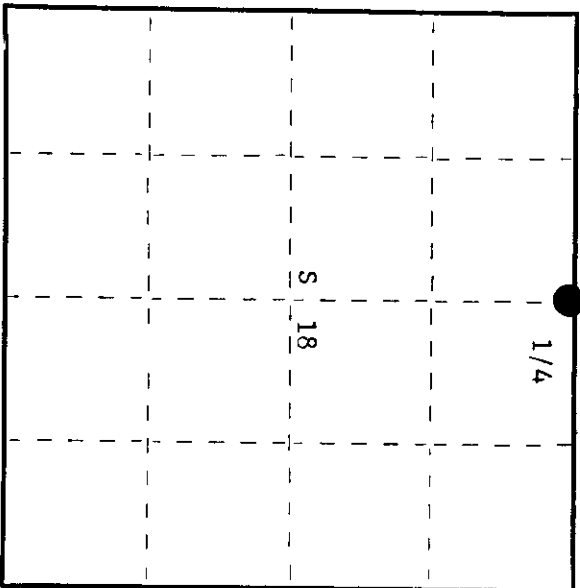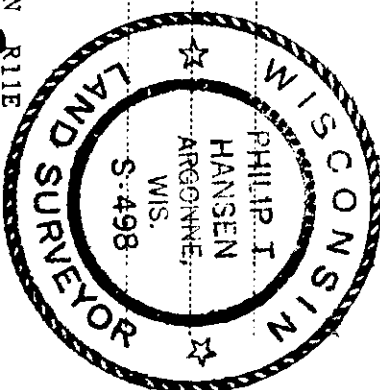

○ = Corner monument restored.

History of original corner establishment:

Original corner established by Wm. E. Dougherty, Deputy Surveyor, in 1859, from which spruce 6" bears N78°E 7 links; spruce 12" bears S21°W 22 links. Corner recovered by B.F. Dorr and perpetuated by D.H. Vaughan. He marked cedar 8" N17½°W, 26 links.

Corner recovered by H.C. Lawrence, Registered Land Surveyor. Found Vaughan's 9T intact. Set new post and marked NBT - Cedar 5" S56°E 49 links.

Description of corner evidence found:

Recovered H.C. Lawrence's 5" squared cedar post in good condition, scribed 1/4S S7, 1/4S S18.

Recovered OBT's -

Cedar 10" S56°E 49.0 links (49.2 links) scribed 1/4S NBT.

Cedar 8" (12") N17°W 26.0 links (28.6 links) scribed 1/4S.

Description of monument and accessories I established to perpetuate the original location of this corner.

Replaced H.C. Lawrence's cedar post with 2½" Berrtsen A-1 Federal Monument.

Monument projects 1' above ground. Cap stamped:

Marked NBT's -

Maple 7" N31°E 32.0 links

Maple 7" S72°W 35.5 links, scribed 1/4 BT.

T36N R11E
1/4 S+7
S18
S498 - 1979

Dated at Rhinelander, Wis., this 24th day of April, 1979.

Signature Philip T. Hansen Title Registered Land Surveyor Registration No. S-498
(County Surveyor, Registered Land Surveyor, or other duly authorized official)

Office of Register of Deeds, County of Oneida, I hereby certify that the within instrument was filed in this office for record on the 14th day of May, 1979 at 1:30 o'clock P. M.

Dennis Verne Kuehn
(Register of Deeds)

By Dennis Verne Kuehn Deputy

07000701193