


CERTIFIED LAND CORNER RESTORATION

Index No. **G-5**

State of Wisconsin


County of Oneida } ss.

I Phillip T. Hansen do hereby certify that on the 20th day of March 1975, I found evidence of the Quarter corner of Sections 7 and 8 Township 36 North, Range 11 East, Fourth Principal Meridian, as described hereon: and that from this evidence I established a new monument and accessories as described hereon to perpetuate the original location of this corner.

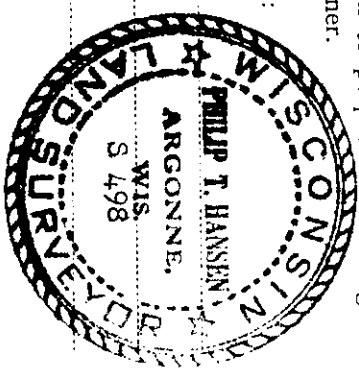

Resident witnesses:

T36N R11E

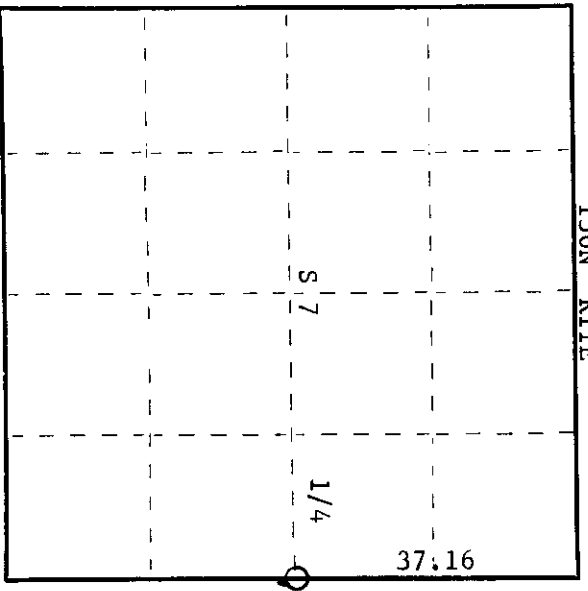

○ = Corner monument restored.

History of original corner establishment:

Original corner established by Wm. E. Dougherty, Gov. Deputy Surveyor, in 1895.

Corner recovered by D.H. Vaughan, County Surveyor, in 1904.

Hemlock 12" N62E 20 1/2 links
Hemlock 13" S36 1/2 E 27 links

Corner recovered by H.C. Lawrence, Reg. Land Surveyor, during his retracement survey of 1946. Recovered stumps of bearing trees with scribing intact from which he set a new cedar post from which NBT oak, 7", bears N56°E, 29 links and sugar maple, 4", bears S54°W, 41 links. Description of corner evidence found:

Recovered a 2" x 6" cedar board, scribed on two sides - 1/4 S7, 1/4 S8, which was banded to a 1 1/2" iron pipe with iron bands; a rock carron had been placed around the post.

Recovered 4" sugar maple, now 9", scribing grown over - S54°W, 41 links and oak 7", now 13", with scribing also grown over.

Description of monument and accessories I established to perpetuate the original location of this corner.

Replaced wooden and iron post with 2 1/2" x 50" galvanized iron pipe w/brass cap stamped -

NBT - oak 10" N62°W 23 links scribed 1/4 BT

S498
T36N R11E

S7	S8
1/4
CPI-1975

Dated at Rhinelander Wis., this 10th day of June 1975.

Signature *Phillip T. Hansen* Title Registered Land Surveyor Registration No. S-498
(County Surveyor, Registered Land Surveyor, or other duly authorized official)

Office of Register of Deeds, County of Oneida. I hereby certify that the within instrument was filed in this office for record on the 1st day of October 1975 at 3:00 o'clock P.M.

Doris Verage Truhan
(Register of Deeds)

By _____ Deputy

3611072000