

CERTIFIED LAND CORNER RESTORATION

Index No. G-3

State of Wisconsin

County of Oneida } ss.



I Phillip T. Hansen, do hereby certify that on the 1st day of June, 1979, I found evidence of the C 1/4 corner of the Section 7 Township 36, North, Range 11 East, Fourth Principal Meridian,

as described hereon; and that from this evidence I established a new monument and accessories as described hereon to perpetuate the original location of this corner.

Resident witnesses:

Jim Clafflin

Herb Wagoner

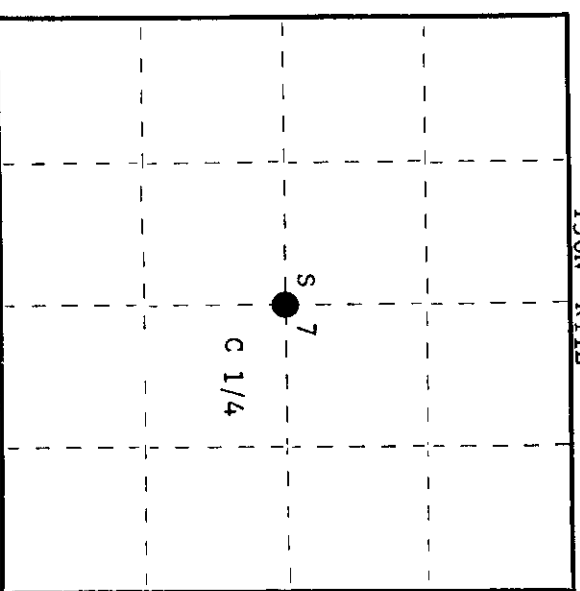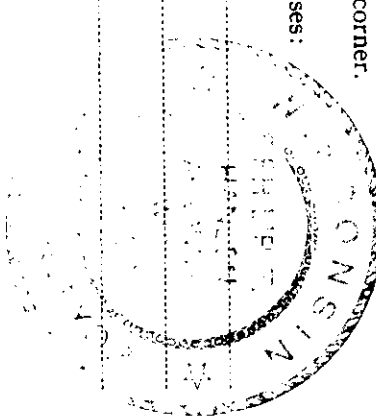

○ = Corner monument restored.

History of original corner establishment:

Corner established by B.F. Dorr, County Surveyor. H.C. Lawrence, Registered Land Surveyor, recovered Dorr's old post and old BT's, Yellow Birch 13" S12°W 31-3/4 links and Cedar 6" S28-1/2°W 23-1/2 links. Lawrence set a new post and marked a Cedar 7" S81°E 16-1/2 links.

Description of corner evidence found:

Recovered H.C. Lawrence's square cedar post, scribed C 1/4 S7 C 1/4 S8. Post was broke in two places. Recovered old hole from BT cross-ties.

Recovered Dorr's - Y. Birch 12" S12°W 31.75 links, our bearing S18°W, now a cut off stump. Cedar 6" (10") S28°W 23.5 links, now a cut off stump, scribed BT. H.C. Lawrence's - Cedar 7" S81°E 16.5 links, now a cut off stump, scribed NBT.

Description of monument and accessories I established to perpetuate the original location of this corner.

Placed a 2" iron pipe with brass cap in correct position. Cap stamped: Monument projects 18" above ground.

Marked NBT - W. Birch 6" S66°W 78.65 links, scribed C 1/4 BT.

NBO - 1" iron pipe S35°E 35.95 links  
1" iron pipe N72°E 17.1 links  
both project 2' above ground.  
Corner sets in a 2 year old cedar slashing.

S498  
T36N R11E  
C 1/4 S7  
CPI-1979

Dated at Rhinelander, Wis., this 12th day of June, 1979

Signature Phillip T. Hansen Title Registered Land Surveyor Registration No. S-498  
(County Surveyor, Registered Land Surveyor, or other duly authorized official)

Office of Register of Deeds, County of Oneida I hereby certify that the within instrument was filed in this office for record on the 7th day of July, 1979 at 1:30 o'clock P. M.

Doreen Wanger-Rueckel  
(Register of Deeds)

By..... Deputy

3611072020