

CERTIFIED LAND CORNER RESTORATION

Index No. **F-3**

State of Wisconsin }
County of **Oneida** } ss.


I **Phillip T. Hansen**, do hereby certify that on the **17th** day of **November**, 1975, I found evidence of the **NC-1/16** corner of **Section 7** Township **36**, North, Range **11 East**, Fourth Principal Meridian,

as described hereon; and that from this evidence I established a new monument and accessories as described hereon to perpetuate the original location of this corner.

Resident witnesses:

Glen Barker

Jim Clafin

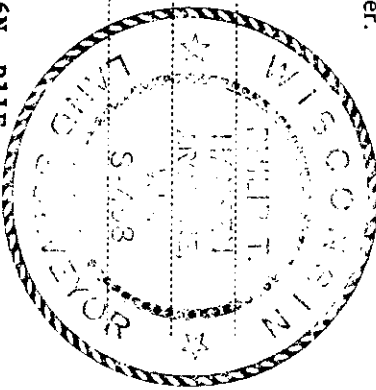

History of original corner establishment:
Corner originally established by D.H. Vaughan, County Surveyor, from which white pine 10" bears N85-1/2°E, 11 lks. and white pine 15" bears N3-3/4°W, 37-1/2 lks. Corner recovered by H.C. Lawrence, Registered Land Surveyor, in 1950. Recovered Vaughan's white pine bearing trees and the rolled portion of his post lying on loose rocks. Set new tamarack 4" post and marked new bearing trees - aspen 8", S83°E, 14 lks. and aspen 9", S48°W, 23 lks.

Description of corner evidence found:

Recovered 4" tamarack post, squared and scribed NC-1/16 S7, NC-1/16 in poor condition with rock cairn around base. Also found an old squared cedar stake lying beside it.


Recovered 0BT's - W. pine stump 15"	N3°45'W	37.5 lks.	badly decayed
W. pine stump 10"	N85°30'E	11 lks.	decayed but BT scribing visible
Aspen 8"	S83°E	14 lks.	now a 10' stub, scribed NC-1/16
Aspen 9"	S48°W	23 lks.	NBT fallen down, NC-1/16 NBT

Description of monument and accessories I established to perpetuate the original location of this corner.

Replaced 4" tamarack post with 1" O.D. iron pipe with 2" brass cap stamped -
Pipe projects 18" above ground. Placed rock cairn around base.
NBT's - B. spruce 6" S88°E 19.7 lks. scribed 1/16 BT S498
W. spruce 6" N52°W 14 lks. scribed 1/16 BT T36N, R11E

WC-1/16 1 S17

CPI-1975

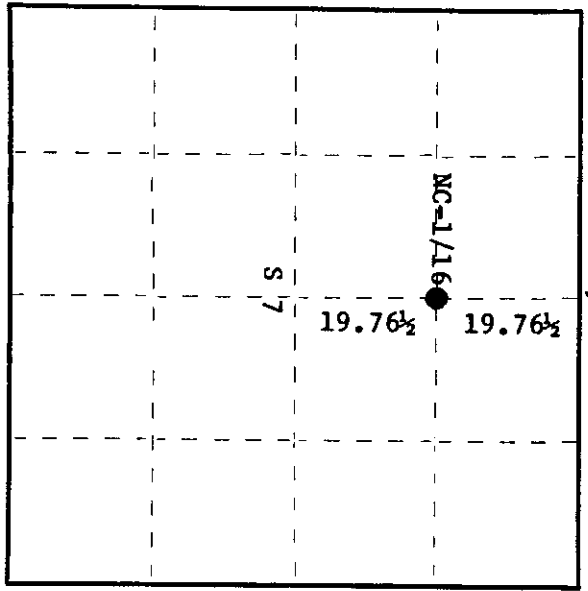

○ = Corner monument restored.

Dated at **Rhineland**, Wis., this **29th** day of **November**, 1975.

Signature *Phillip T. Hansen* Title **Registered Land Surveyor** Registration No. **S-498**
(County Surveyor, Registered Land Surveyor, or other duly authorized official)
Office of Register of Deeds, County of **Oneida**
at **1:00** o'clock **P.** M. I hereby certify that the within instrument was filed in this office for record on the **17th** day of **November**, 1975.

Signature *James Lawrence*
(Register of Deeds)

By: _____ Deputy