



CERTIFIED LAND CORNER RESTORATION

Index No. **5-11**

State of Wisconsin } ss.  
 County of Oneida

I Phillip T. Hansen, do hereby certify that on the 31st day of January, 1975, I found evidence of the 1/4 corner of Section 9-16 Township 36, North, Range 11 East, Fourth Principal Meridian, as described hereon; and that from this evidence I established a new monument and accessories as described hereon to perpetuate the original location of this corner.

Resident witnesses:

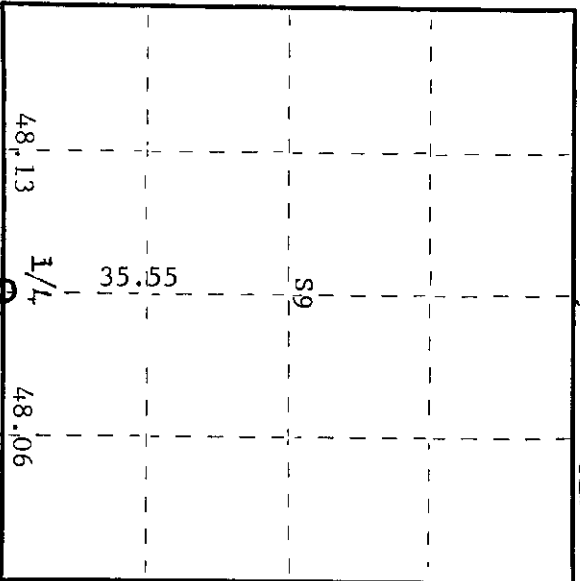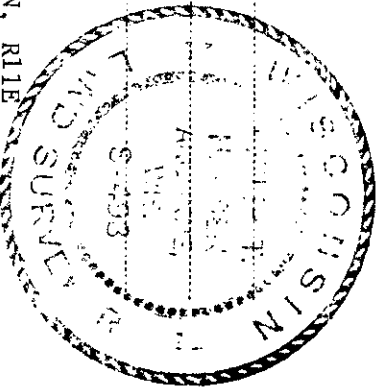

○ = Corner monument restored.

CERTIFIED LAND CORNER RESTORATION

History of original corner establishment:  
 Original corner established by Wm. E. Dougherty, Gov't Deputy Surveyor, in 1859.

Recovered by B.F. Dorr in 1898 (County Surveyor).  
 Cedar 11" N81°W 76 links  
 Cedar 14" S56W 12 links  
 Tamarack 15" S14½W 42 links  
 Pine 12" S81°W 30 links

H.C. Lawrence, Registered Land Surveyor, recovered Dorr's post and stumps of BT's in 1956. No new BT's were set. Set 4" cedar post, squared and scribed 59-1/4S S16.

Description of corner evidence found:  
 Recovered H.C. Lawrence's 4" cedar post, squared and scribed S9-1/4S S16 in poor condition. No trace of old BT's.

Description of monument and accessories I established to perpetuate the original location of this corner.  
 Replaced wooden post with 2-1/2" x 5' galvanized iron pipe with brass cap stamped -

New BT's. White birch 6" N14°E 85 links scribed 1/4 BT  
 White birch 8" S23°W 70.6 links scribed 1/4 BT

S498  
 T36N, R11E  
 1/4 S | 9  
 S | 16

CPL-1975

Dated at Rhineland, Wis., this 16th day of June, 1975.

Signature Phillip T. Hansen Title Registered Land Surveyor Registration No. S-498  
 (County Surveyor, Registered Land Surveyor, or other duly authorized official)

Office of Register of Deeds, County of Oneida.  
 Instrument was filed in this office for record on the 1st day of October, 1975 at 3:00 o'clock P. M.

Donna Verage Guerin  
 (Register of Deeds)

By: \_\_\_\_\_ Deputy

3611090020