

CERTIFIED LAND CORNER RESTORATION


Index No. **G-11**

State of Wisconsin


County of Oneida } ss.

I Philip T. Hansen, do hereby certify that on the 8th day of January, 1975, I found evidence of the C-1/4 corner of Section 9 Township 36, North, Range 11 East, Fourth Principal Meridian, as described hereon; and that from this evidence I established a new monument and accessories as described hereon to perpetuate the original location of this corner.

Resident witnesses:

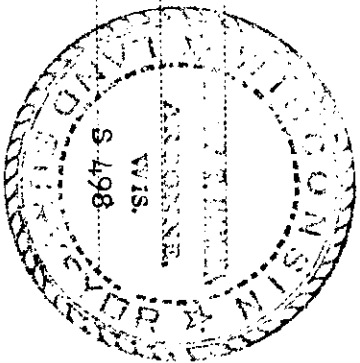

T36N, R11E

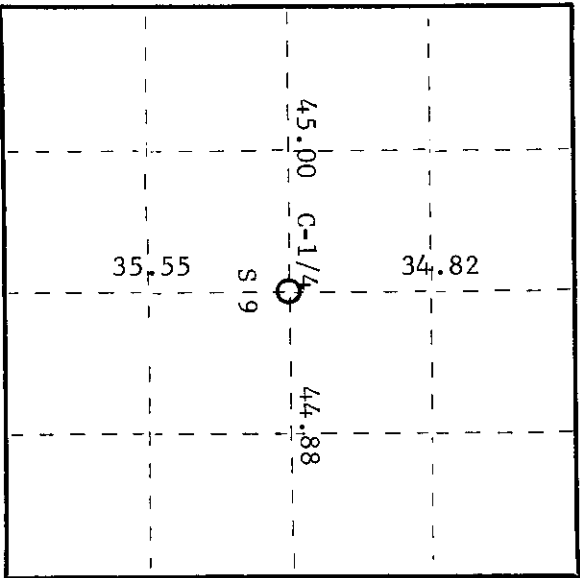

○ = Corner monument restored.

History of original corner establishment:

Original corner established by D.H. Vaughan, County Surveyor. Corner recovered by H.C. Lawrence, Reg. Land Surveyor in 1947, while running the N-S 1/4 line for retracement purposes. He set a 4" squared cedar post but does not make mention of any BT's established.

Description of corner evidence found:

Recovered 4" cedar post, squared and scribed C-1/4S S9 C-1/4S in poor condition. Unable to recover any bearing trees.

Description of monument and accessories I established to perpetuate the original location of this corner.

Set 2-1/2" x 5' galvanized iron pipe with brass cap stamped -

S-498  
T36N, R11E

C-1/4 S 19

CPI-1975

Dated at Rhineland, Wis., this 16th day of June, 1975.

Signature: Philip T. Hansen Title: Registered Land Surveyor Registration No. S-498  
(County Surveyor, Registered Land Surveyor, or other duly authorized official)

Office of Register of Deeds, County of Oneida. I hereby certify that the within instrument was filed in this office for record on the 1st day of October, 1975 at 3:00 o'clock P. M.

Doris Verage Kuehn  
(Register of Deeds)

By: \_\_\_\_\_ Deputy

3611092020