

CERTIFIED LAND CORNER RESTORATION

Index No. **F-11**



State of Wisconsin }  
 County of Oneida } ss.

I Phillip T. Hansen, do hereby  
 certify that on the 29th day  
 of January, 1975, I found

evidence of the NC-1/16  
 corner of Section 9  
 Township 36 North, Range  
 11 E, Fourth Principal Meridian,

as described hereon; and that from this evidence  
 I established a new monument and accessories  
 as described hereon to perpetuate the original  
 location of this corner.

Resident witnesses

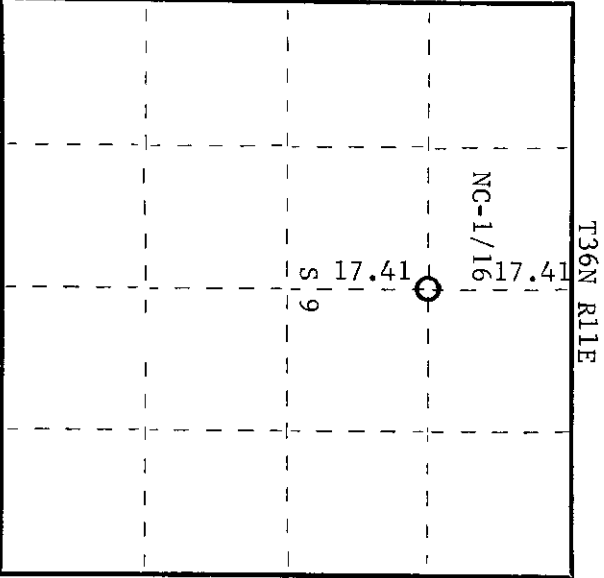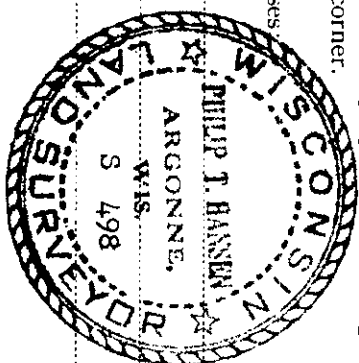

○ = Corner monument restored.

History of original corner establishment:

Corner established by H.C. Lawrence, Registered Land Surveyor, during his retracement survey and subdivision survey dated 8/15/52. Set the NC-1/16 corner equidistant between the C-1/4 corner and N-1/4 corner at 17.41 chains. Set 3" cedar post 52.96 chains North 3°00'E of S-1/4 corner.

BT's - Cedar 7" N29°E 52 links  
 Cedar 6" N5°E 58 links

Description of corner evidence found:

Recovered H.C. Lawrence's 3" cedar post, squared and scribed NC-1/16 S9 NC-1/16 in poor condition.

Recovered - Cedar 7" N29°E 52 links scribed 1/16 BT  
 Cedar 6" N5°E 58 links faced but not scribed

Description of monument and accessories I established to perpetuate the original location of this corner.

Replaced 3" cedar post with 1-1/4"OD x 5' galvanized iron pipe with 2" brass cap stamped -

NBT - Cedar 8" N86°E 43.4 links scribed 1/16 BT

NC-1/16 **S9**  
 CPT-1975

T36N R11E

Dated at Rhinelanders, Wis., this 16th day of June, 1975.

Signature *Phillip T. Hansen* Title Registered Land Surveyor Registration No. S-498  
 (County Surveyor, Registered Land Surveyor, or other duly authorized official)

Office of Register of Deeds, County of Oneida  
 Instrument was filed in this office for record on the 1st day of October, 1975  
 at 3:00 o'clock P.M.

*Donie Savage Kuehn*  
 (Registered Deeds)

By: Deputy

3611093020