
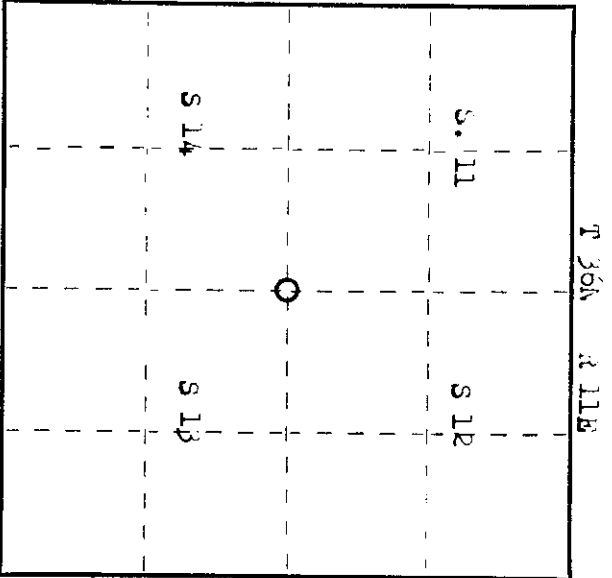


State of Wisconsin } ss.
 County of Oneida

I, Phillip T. Hansen, do hereby certify that on the 5th day of December, 1974, I found evidence of the corner of 11, 12, 13 and 14 Township 36 North, Range 11 East, Fourth, Principal Meridian, as described hereon; and that from this evidence I established a new monument and accessories as described hereon to perpetuate the original location of this corner.

Resident witnesses:

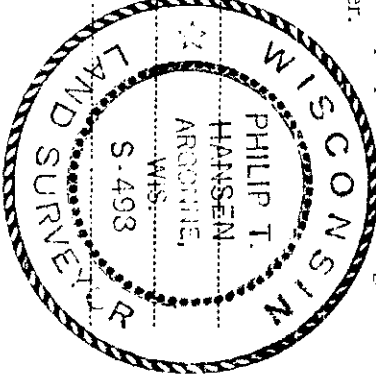

○ = Corner monument restored.

CERTIFIED LAND CORNER RESTORATION

Index No. J-21

History of original corner establishment:

Original corner established by William E. Dougherty, Gov. Deputy Surveyor in 1957.

Spruce 6" S61W 36 lks.
 Fir 6" S32E 42 lks.

Description of corner evidence found: Recovered 4 inch cedar post, scribed S11, S12, S13 & S14 in fair condition set by H.C. Lawrence in 1950. From his notes a describes finding an old squared spruce, well grown over, considered to be the section corner. He found no evidence of an Bearing trees.

No evidence of bearing trees were found.

Description of monument and accessories I established to perpetuate the original location of this corner. Set a 2 1/2" x 5" galvanized iron pipe with brass cap stamped as follows:

Blazed and scribed the following BTS
 Black spruce 7" N34E 24 1/2 lks T 36N R11E
 Black spruce 7" N6E 25 lks S11 | S12
 S14 | S13

S 493
 CPI 1974

Dated at Philetasser, Wis., this 17th day of December, 1974.

Signature Phillip T. Hansen Title Surveyor Registration No. S-493
 County Surveyor, Registered Land Surveyor, or other duly authorized official)

Office of Register of Deeds, County of Oneida. On 1st day of October, 1975 at 3:00 o'clock P. M. I hereby certify that the within instrument was filed in this office for record on the

Toni Verage Kuehn
 (Register of Deeds)

By: _____ Deputy

361110000