


CERTIFIED LAND CORNER RESTORATION

Index No. F-25

State of Wisconsin }
County of Oneida } ss.

I Philip T. Hansen, do hereby certify that on the 12th day of December, 1974, I found evidence of the N-1/16 corner of 7-12 Township 36, North, Range 11-12, Fourth Principal Meridian, as described hereon; and that from this evidence I established a new monument and accessories as described hereon to perpetuate the original location of this corner.

Resident witnesses.

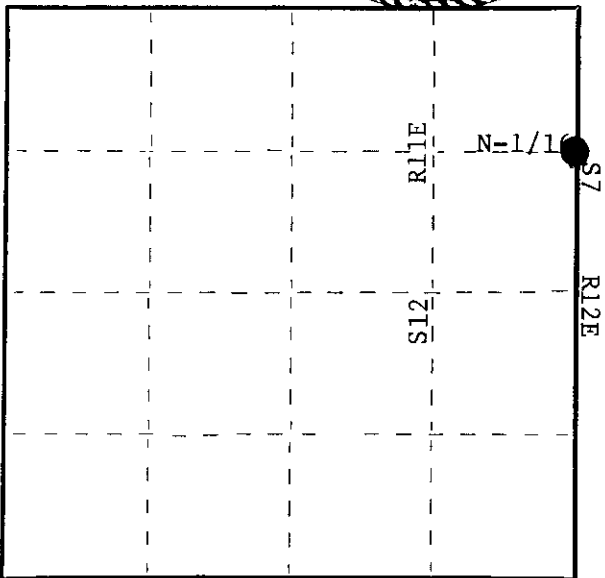

○ = Corner monument restored.

History of original corner establishment:

Original corner established by B.F. Dorr in 1897. H.C. Lawrence retracement survey of 1956 states that when he ran the range line south from NE corner, Section 12, he recovered the N-1/16 corner 2 links east of his line. He recovered the 1/4 corner 5 links east of his line. No mention was made in Dorr's notes about running the east line of Section 12. The recovered 1/16 corner probably set by someone else. Lawrence set his post at 19.99 chains, equidistant between the section corner and the 1/4 corner.

Black spruce 5" S60W 12½ links
Black spruce 4" S60E 28½ links

Description of corner evidence found:


Recovered H.C. Lawrence's 4" cedar post, squared and scribed S12 N-1/16; S7 N-1/16

Recovered Black spruce 5" S62W 12½ links Scribed S12 B.T.
Black spruce stump S58W 29 links Scribed B.T.

Description of monument and accessories I established to perpetuate the original location of this corner.

Set new 1" x 5' galvanized iron pipe with brass cap stamped -

N.B.T. Black spruce 4" N17W 33 links Scribed 1/16 B.T. S498
T36N

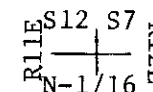

CPI-1974

Dated at Rhineland, Wis., this 16th day of June, 1975.

Signature Philip T. Hansen Title _____ Registration No. _____
(County Surveyor, Registered Land Surveyor, or other duly authorized official)

Office of Register of Deeds, County of Oneida, I hereby certify that the within instrument was filed in this office for record on the 1st day of October, 1975 at 3:00 o'clock P M.

Doris Verage Kuehn
(Register of Deeds)

By _____ Deputy

FORM 983 K. C. MILLER CO., MILWAUKEE

361123000