

CERTIFIED LAND CORNER RESTORATION


Index No. **M-25**

State of Wisconsin


County of Oneida } ss.

I Phillip T. Hansen, do hereby certify that on the 7th day of October, 1975, I found evidence of the S-1/16 corner of Sections 13 and 18 Township 36 North, Range 11 and 12 East Fourth Principal Meridian, as described hereon, and that from this evidence I established a new monument and accessories as described hereon to perpetuate the original location of this corner.

Resident witnesses:
Glen Barker
Jim Claflin

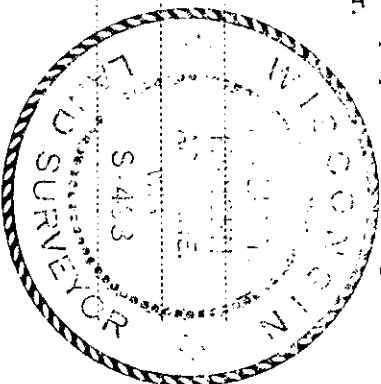

T36N R11E

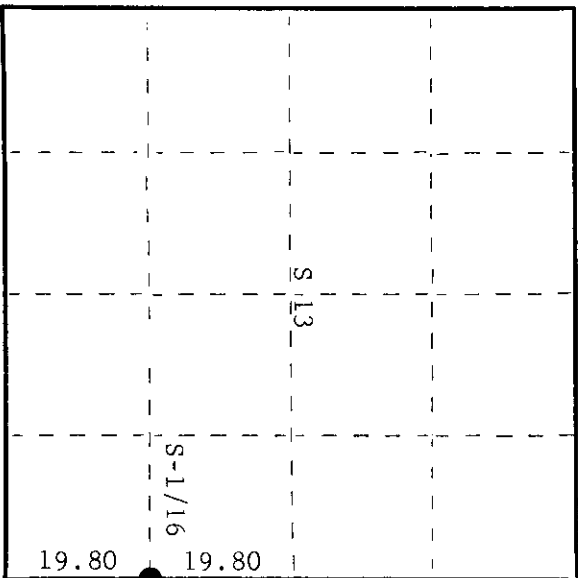

○ = Corner monument restored.

3611131000

History of original corner establishment: Corner established by H.C. Lawrence, Registered Land Surveyor, in 1950. He ran a random line S3°00'W, from section corner 12,7, 18, and 13; a distance of 79.20 chains, at which point the section corner was 7.00 chains east. Corrected bearing - S2°05'E. He was unable to recover 1/4 corner on this line, so set it equidistant at 39.60 chains and 3.50 chains east of random line. Set S-1/16 at 19.80, equidistant between 1/4 corner and SE corner and 5.25 chains east of random line. Set new tamarack post, in stand of small tamarack.

Description of corner evidence found: Recovered 5" tamarack post, squared and scribed S-1/16 S6, S-1/16 S5, in fair condition.

No BT's were recovered.

Description of monument and accessories I established to perpetuate the original location of this corner. Replaced 5" tamarack post with 1 1/2" O.D. iron pipe with 2" brass cap stamped -

As this area is all backwater of beaver dam and no trees were available for BT's, two 1 1/2" O.D. iron pipes with brass caps were set for witness corners.

Post and witness corners were painted blue.

S498			
T36N			
R	S-1/16	S13	S18
E	11		12

#2 scribed - W	C
E30	links

Dated at Rhineland, Wis., this 13th day of October, 1975.

Signature: *Phillip T. Hansen* Title: Registered Land Surveyor Registration No. S-498
(County Surveyor, Registered Land Surveyor, or other duly authorized official)

Office of Register of Deeds, County of Oneida
Instrument was filed in this office for record on the 5th day of December, 1975 at 10:00 clock A.M.

Dennis George Fuchs
(Register of Deeds)

By: Deputy