

CERTIFIED LAND CORNER RESTORATION

Index No. L-25



State of Wisconsin

County of Oneida } ss.

I, Phillip T. Hansen, do hereby certify that on the 18th day of March, 1976, I found evidence of the quarter corner of Sec. 13 and 18 Township 36, North, Range 11 East, Fourth Principal Meridian, as described hereon; and that from this evidence I established a new monument and accessories as described hereon to perpetuate the original location of this corner.

Resident witnesses:

Glen Barker
Jim Claflin
Herb Jagoner

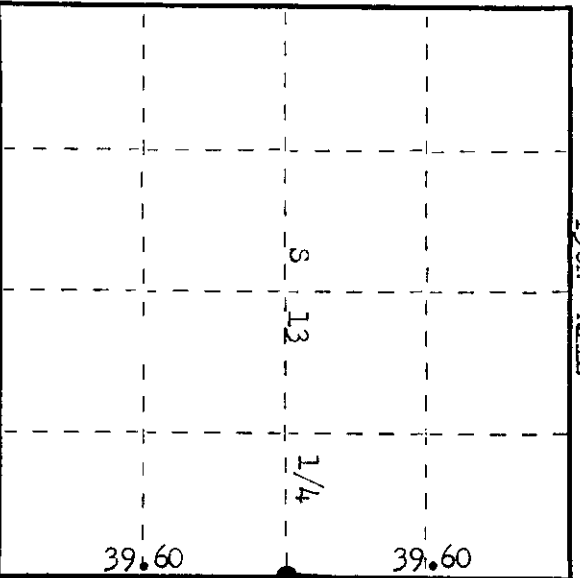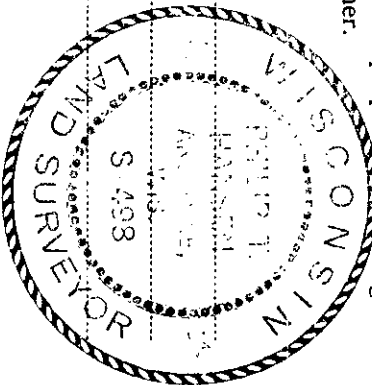

○ = Corner monument restored.

History of original corner establishment:

Original corner established by Alfred Willard, Deputy Surveyor, in 1858, from which Elm 7" bears N 50° W and Elm 12" bears S 70° E 46 lks. Corner re-established by H. C. Lawrence, Registered Land Surveyor, in 1950. From Section Corner 12, 7, 18, 13, he ran south 30° west a distance of 79.20 chains to a point 7.0 chains west of the Section Corner. Set 1/4 corner at 39.60 chains, and 3.50 chains east. He made an intensive search of area, but was unable to recover old corners.

Description of corner evidence found:

Recovered 5" cedar post, squared and scribed 1/4 S S13, 1/4 S S18 in fair condition. Unable to recover any OBTs.

Description of monument and accessories I established to perpetuate the original location of this corner.

Replaced 5" cedar post with 2 1/2" Bernitsen A-1 Federal Monument, aluminum with magnet installed in cap and base. Pipe projects 2' above ground. Cap stamped.
NBTs - Aspen 12" S 64° N 28.7 lks, scribed 1/4 BT.
Aspen 10" N 10° W 80 lks, scribed 1/4 BT.
Pipe and BTs painted blue.

	T36N	
R 1	13	18
11	4	12
E	5498	E
	1976	

Dated at Waukegan, Wis., this 23rd day of March, 1976

Signature Phillip T. Hansen Title Registered Land Surveyor Registration No. 5-498
(County Surveyor, Registered Land Surveyor, or other duly authorized official)

Office of Register of Deeds, County of Oneida.
Instrument was filed in this office for record on the 5th day of April, 1976 at 1:30 o'clock P. M.

David George Kuehn
(Register of Deeds)

By _____ Deputy

3611132000