

CERTIFIED LAND CORNER RESTORATION



Index No. L-12

State of Wisconsin

County of Oneida } ss.

I, Philip T. Hansen, do hereby certify that on the 7th day of February, 1975, I found evidence of the EC-1/16 corner of Section 16, Township 36 North, Range 11 East, Fourth Principal Meridian, as described hereon; and that from this evidence I established a new monument and accessories as described hereon to perpetuate the original location of this corner.

Resident witnesses:

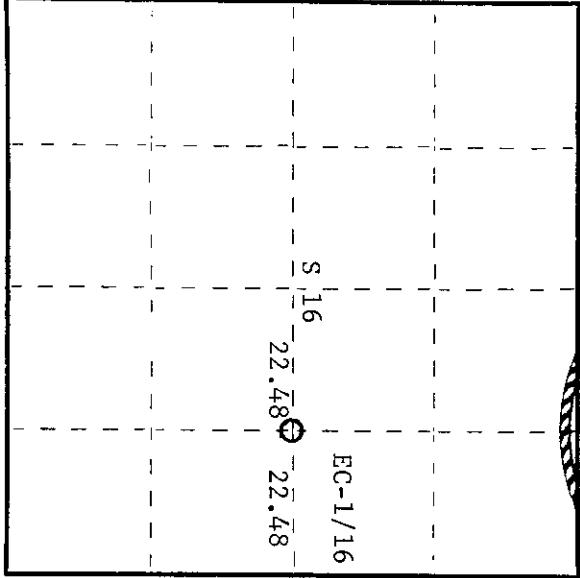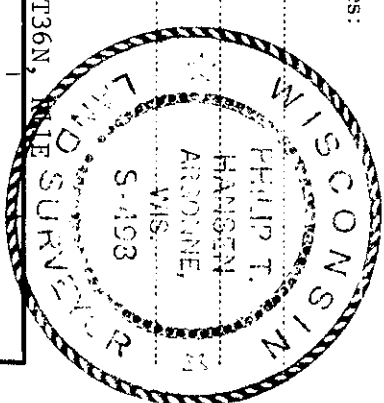

○ = Corner monument restored.

361116 2010

History of original corner establishment:

Original corner established by H.C. Lawrence, Registered Land Surveyor, during his retracement survey in 1946. He ran a random line due east 44.96 chains at which point B.F. Dorr's 1/4 corner is 117 links south. He corrected the line and set a 4" cedar post at point 58 links south and equidistant at 22.48 chains. Corrected bearing of line is S88°30'E.

No record of BT's.

Description of corner evidence found:

Recovered H.C. Lawrence's 4" cedar post, squared and scribed EC-1/16 S16 in fair condition.

Description of monument and accessories I established to perpetuate the original location of this corner.  
Set new 1-1/4" O.D. x 5' galvanized iron pipe with brass cap stamped -

- |                      |       |            |                 |            |
|----------------------|-------|------------|-----------------|------------|
| NBT - White birch 8" | N32°E | 68.7 links | scribed 1/16 BT | S498       |
| White birch 11"      | N38°W | 36.7 links | scribed 1/16 BT | T36N, R11E |

S+16 EC-1/16  
CPI-1975

Dated at Rhinelander, Wis., this 16th day of June, 1975.

Signature Philip T. Hansen Title Registered Land Surveyor Registration No. S-498  
(County Surveyor, Registered Land Surveyor, or other duly authorized official)

Office of Register of Deeds, County of Oneida, at 300 o'clock M. On 1st day of October, 1975. I hereby certify that the within instrument was filed in this office for record on the 1st day of October, 1975.

Doris Savage Fischer  
(Register of Deeds)

By: Deputy