



CERTIFIED LAND CORNER RESTORATION

Index No. K-11

State of Wisconsin }
County of Oneida } ss.

I Philip T. Hansen do hereby certify that on the 1st day of April, 1975, I found evidence of the NC-1/16 corner of Section 16 Township 36 North, Range 11 East, Fourth Principal Meridian, as described hereon; and that from this evidence I established a new monument and accessories as described hereon to perpetuate the original location of this corner.

Resident witnesses:

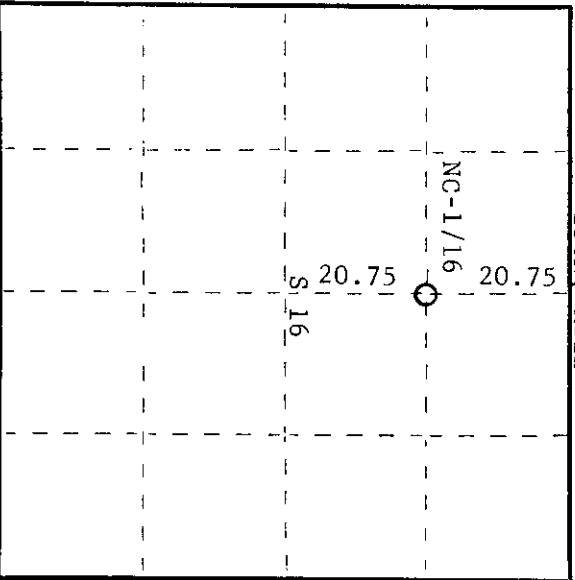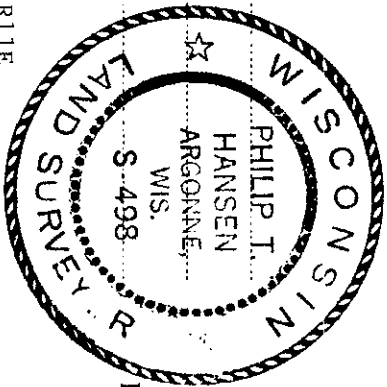

○ = Corner monument restored.

CERTIFIED LAND CORNER RESTORATION

History of original corner establishment:

Original corner established by B.F. Dorr, County Surveyor, in 1898. Corner re-established by H.C. Lawrence, Registered Land Surveyor, in 1946 during his retracement survey. From re-established N-1/4 corner ran random line S10°E 41.50 chains to a point 3.83 chains West of Dorr's C-1/4 corner. Corrected bearing S60°17'E. He set new cedar post in Dorr's old posthole at C-1/4. Set new cedar post at NC-1/16 but no mention of BT's established at point equidistant at 20.75 chains.

Description of corner evidence found:

Recovered 4" cedar post, squared and scribed S16 NC-1/16, in fair condition.
Recovered OBT's - Cedar 9" S74°E 26.4 links scribed NC-1/16 BT
Cedar 12" S69°W 29.4 links scribed S16 BT

Description of monument and accessories I established to perpetuate the original location of this corner.
Wooden post replaced with 1-1/2" iron pipe with brass cap stamped -
No new BT's established.

NC-1/16 S116

T36N, R11E
CPI-1975

Dated at Rhinelander, Wis. this 9th day of May, 1975.

Signature: Philip T. Hansen Title: Registered Land Surveyor Registration No. S-498
(County Surveyor, Registered Land Surveyor, or other duly authorized official)

Office of Register of Deeds, County of Oneida
Instrument was filed in this office for record on the 1st day of October, 1975 at 3:02 o'clock P.M.

Toni Verage Fuchs
(Register of Deeds)

By: _____ Deputy