



CERTIFIED LAND CORNER RESTORATION

Index No. L-8

State of Wisconsin }
County of Oneida } ss.

I, Philip T. Hansen, do hereby certify that on the 4th day of April, 1980, I found evidence of the EC 1/16 corner of Section 17 Township 36 North, Range 11 East, Fourth Principal Meridian, as described hereon; and that from this evidence I established a new monument and accessories as described hereon to perpetuate the original location of this corner.

Resident witnesses:
Jim Clafin
Herb Wagoner

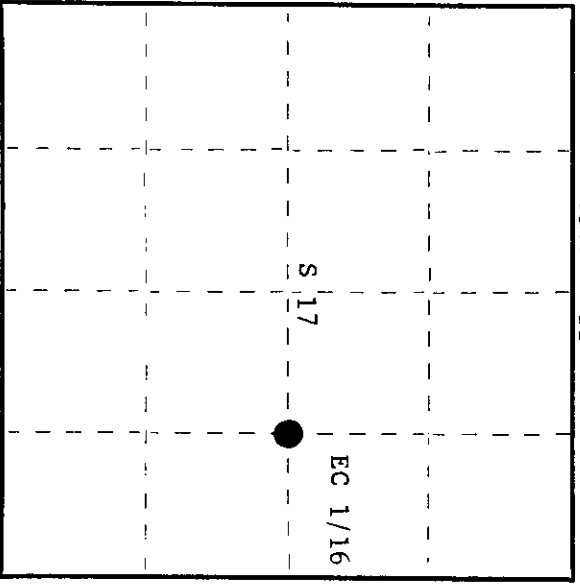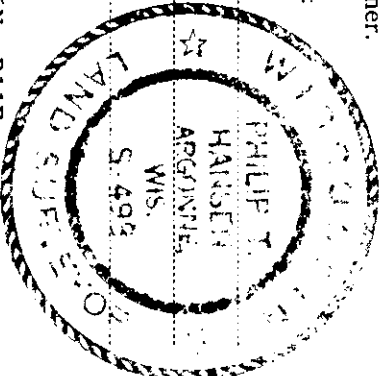

○ = Corner monument restored.

History of original corner establishment:

Corner established by Goddard and crew, Ripco surveyors. Ran N-S and E-W 1/4 lines to establish C 1/4 corner. Random line E-W 1/4 east from W 1/4 corner bearing 87° 50' 82.72 chains to close out 1.16-1/4 chains north of E 1/4. Set C 1/4 at 41.39 chains 62 links south. Set the EC 1/16 at 62.055 chains 89-1/4 links south.

Marked NBT's - Cedar 9" N19°W 15-1/2 links
Ash 3" S63°E 29 links
Corrected bearing N 88° 38' E.

Description of corner evidence found:
Recovered Goddard's 4" square cedar post scribed CE-1/16 S17.
Recovered OBT's -
Cedar 9" N19°W 15.5 links, scribed CE 1/16 BT.
Ash 3" (5") S63°E 29.0 links, scribing grown over.

Description of monument and accessories I established to perpetuate the original location of this corner.
Replaced 4" squared cedar with 1-1/2" iron pipe with 2" brass cap, stamped:
Monument projects 12" above ground.
Marked NBT - Cedar 6" N83°W 11.3 links, scribed 1/16 BT.

T36N R11E
S 17
EC 1/16
CPI-1980

Dated at Rhineland, Wis., this 19th day of May, 1980.

Signature Philip Hansen Title Registered Land Surveyor Registration No. S-498
(County Surveyor, Registered Land Surveyor, or other duly authorized official)
Office of Register of Deeds, County of Oneida
Instrument was filed in this office for record on the 5th day of June, 1980 at 1:30 o'clock P. M.

Donna Leverage Kuehn
(Register of Deeds)

By: _____ Deputy

0102011736