

CERTIFIED LAND CORNER RESTORATION

Index No. 0-3

State of Wisconsin

County of Ozaukee } ss.

I Phillip T. Hansen

certify that on the 1st day

of December, 19 76, I found

evidence of the MC 1/16

corner of Section 19

Township 36

11 East, North, Range

11 East, Fourth Principal Meridian,



as described hereon; and that from this evidence I established a new monument and accessories as described hereon to perpetuate the original location of this corner.

Resident witnesses:

Glen Barler

Jim Charltn

Herb Wagoner

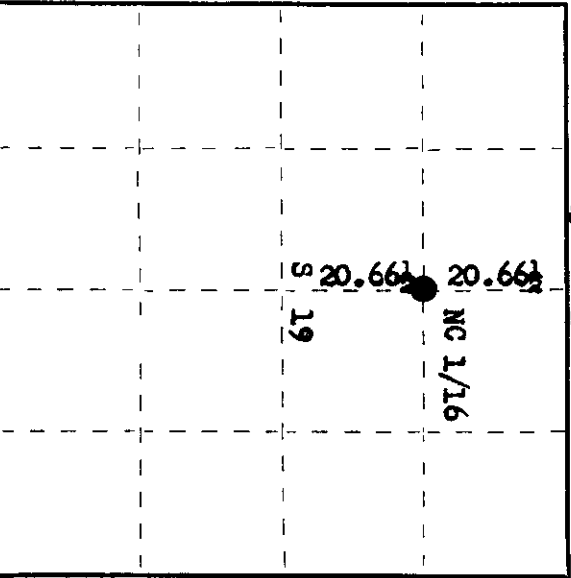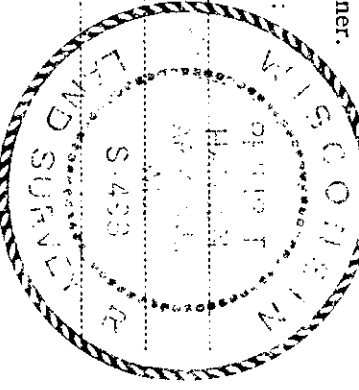

History of original corner establishment:

Original Corner established by D.H. Vaughan, County Surveyor, in 1900. Set post and marked BT - White Birch 30" S 51° W 16.5 links.

Corner recovered by H.C. Lawrence, Registered Land Surveyor, in 1953. Recovered Vaughan's White Birch, then a stump, with scribe marks visible. A wire fence runs south on the 1/4 line to C 1/4 and fence line runs west and also east. Scribed corner fence post for corner.

Description of corner evidence found:

Recovered corner fence post, scribed MC 1/16. Recovered Vaughan's OBT - White Birch 30" S 51° W 16.5 links, now a decayed stump. Lawrence's - Balsam stub N 19° E 19 links, scribed 1/16 visible.

No record of this BT.

Description of monument and accessories I established to perpetuate the original location of this corner.

Set a 1 1/2" iron pipe with 2" brass cap on the west edge of the old fence post, which tied to Vaughan's OBT. Cap stamped:

Monument projects 2' above ground.

NBTs - Black Spruce 16" due north, 98.5 links, scribed 1/16 BT.

Maple 8" N 54° W 76.8 links, scribed 1/16 BT.

S4,98  
T36N R11E  
MC 1/16 S 112  
CPI-1976

Dated at Rhinelander, Wis., this 13th day of December, 19 76

Signature Phillip T. Hansen Title Registered Land Surveyor Registration No. 5498  
(County Surveyor, Registered Land Surveyor, or other duly authorized official)

Office of Register of Deeds, County of Ozaukee I hereby certify that the within instrument was filed in this office for record on the 20th day of December, 19 76 at 10 o'clock P. M.

Jane Virginia Kuehn  
(Register of Deeds)

By: \_\_\_\_\_ Deputy