

CERTIFIED LAND CORNER RESTORATION

Index No. **R-23**



State of Wisconsin

County of Oneida } ss.

I Phillip T. Hansen, do hereby certify that on the 26th day of July, 1976, I found evidence of the quarter corner of Section 24 and 25 Township 36 North, Range 11, East, Fourth Principal Meridian, as described hereon; and that from this evidence I established a new monument and accessories as described hereon to perpetuate the original location of this corner.

Resident witnesses:

Glen Barker
Jim Clavin
Herb Lagoner

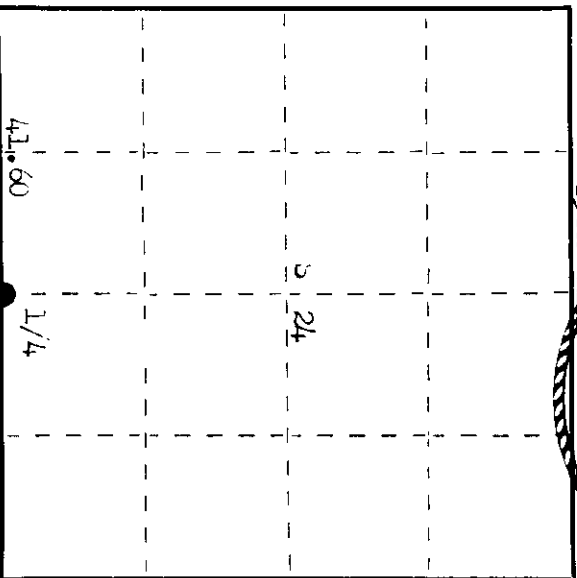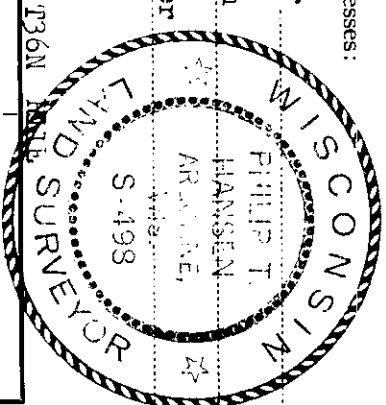

○ = Corner monument restored.

History of original corner establishment:

Original Corner established by Wm. D. Dougherty, Deputy Surveyor, in 1859, from which Tamarack 10" bears S 3° E 10 links and Tamarack 10" bears N 45° E 11 links.

Corner recovered by B.F. Dorr, County Surveyor, in 1899. Recovered original BT's and set corner from them.

H.C. Lawrence, Registered Land Surveyor, found Dorr's old post while cruising in 1946. Found remains of original Tamarack BT's - set new post.

Description of corner evidence found:
Recovered 4" cedar post laying down, squared and scribed 1/4 S 24, 1/4 S 25. Recovered hole where post had stood.

Recovered original Tamarack 10" S 45° E 11 links, now a decayed mound.
Tamarack 10" S 3° E 10 links, now a decayed mound.

Description of monument and accessories I established to perpetuate the original location of this corner.
Replaced wood post with 2 1/2" birch post. Federal monument, stamped.

Monument projects 18" above ground. 130W 11E
BT - W. spruce 10" N 75° E 15.8 links, scribed 1/4 BT. 1/4 S 24
Corner sets in a tag alder swamp. No other BT's near. 1/4 S 25
Location tag 5.5 chains south of corner. 3498-1976
Monument and BT's painted blue.

Dated at Oneida, Wis., this 23rd day of August, 1976

Signature: *Phillip T. Hansen* Title: Registered Land Surveyor Registration No. S-498
(County Surveyor, Registered Land Surveyor, or other duly authorized official)

Office of Register of Deeds, County of Oneida. I hereby certify that the within instrument was filed in this office for record on the 23rd day of September, 1976, at 2:10 o'clock P.M.

Signature: *Louise Verage-Fischer*
(Register of Deeds)

By: Deputy

0700521192