

CERTIFIED LAND CORNER RESTORATION

Index No. **T-23**


State of Wisconsin

County of Oneida } ss.

I Philip T. Hansen, do hereby certify that on the 30th day of June, 1975, I found evidence of the C-1/4 corner of Section 25 Township 36, North, Range 11 East, Fourth Principal Meridian,

as described hereon; and that from this evidence I established a new monument and accessories as described hereon to perpetuate the original location of this corner.

Resident witnesses:

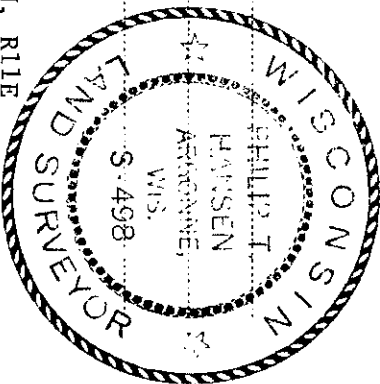


History of original corner establishment:
Established by B.F. Dorr, County Surveyor, in 1899 from which cedar 7" bears S1°W, 5 links and tamarack 13" bears N64½°W, 28-3/4 links.
H.C. Lawrence, Registered Land Surveyor, recovered this corner in 1946. He found Dorr's old post and his BT's. Both BT's were stumps but bearings and distances checked out. He set a new cedar post in place of recovered post and made NBT white birch 12", S75°E, 35½ links.

Description of corner evidence found:
Recovered 4" cedar post, squared and scribed C-1/4 S25, in fair condition and in place. Also found a point of old cedar post lying beside it.
Recovered OBT's - cedar stump 7", S1°W, 5 links, scribing visible but badly decayed; tamarack 13", N64°30'W, 28.75 links, badly decayed; and white birch 12", S75°E, 35½ links, now a decayed stump.

Description of monument and accessories I established to perpetuate the original location of this corner.

Replaced 4" cedar post with 2½" iron pipe with brass cap stamped - S498
T36N, R11E
NBT's - Cedar 8" S35°W 15 links scribed 1/4 BT
Cedar 6" S43°E 21 links scribed 1/4 BT C-1/4 S25

CPI-1975

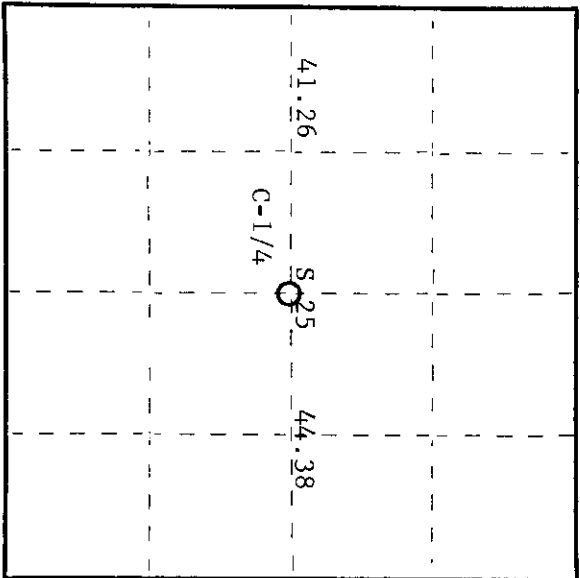

○ = Corner monument restored.

Dated at Rhineland, Wis., this 18th day of July, 1975.

Signature Philip T. Hansen Title Registered Land Surveyor Registration No. S-498
(County Surveyor, Registered Land Surveyor, or other duly authorized official)

Office of Register of Deeds, County of Oneida
Instrument was filed in this office for record on the 1st day of October 1975
at 3:00 o'clock P. M.

Doris Terge Fuchs
(Register of Deeds)

By Doris Terge Fuchs Deputy

0202541198