

CERTIFIED LAND CORNER RESTORATION

Index No. **S-22**

State of Wisconsin

County of Oneida } ss.

I Phillip T. Hansen do hereby certify that on the 26th day of July 1976 I found evidence of the NW 1/16 corner of Section 25

Township 36 North, Range 11 East, Fourth Principal Meridian,



I established a new monument and accessories as described hereon to perpetuate the original location of this corner.

Resident witnesses:

Glen Barker

Jim Clartin

Harv Wagoner

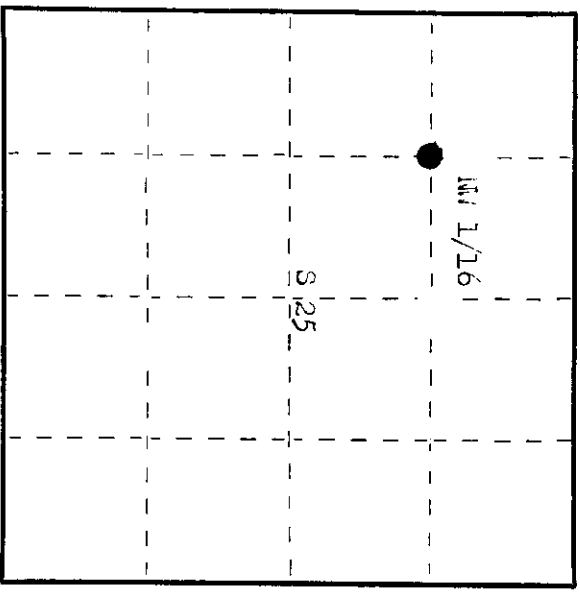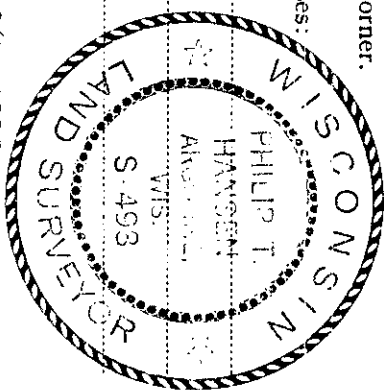

O = Corner monument restored.

History of original corner establishment:

Corner established by H.C. Lawrence, Registered Land Surveyor, in 1954. From re-established NW 1/16 from Dorris Tarabuck BT he ran N 89° 30' E 41.00 chains to intersect section line 104 links north of Dorris N 1/16 corner. set NW 1/16 corner at 22 links south of 20.80 links equidistant. Marked BT's - Cedar 7" S 9° E 19 links and Cedar 8" N 36° E 19 1/2 links.

Description of corner evidence found:

Recovered 5" cedar post, squared and scribed NW 1/16 S25, NW 1/16 S25 in good condition.

Recovered CBT - Cedar 7" (8") S 9° E 19 links, scribed NW 1/16 BT. Cedar 8" N 36° E 19.5 links, scribed S25 BT.

Description of monument and accessories I established to perpetuate the original location of this corner. Replaced 5" cedar post with 1 1/2" W iron pipe with 2" brass cap stamped. monument projects 4" above ground.

BT's - Cedar 9" S 22° E 23 links, scribed 1/16 BT. Corner is located 1 chain east of north end of old 1-3 logging road. Monument and BT's painted blue. NW 1/16 S 25 T36N R11E Cr-I-1976

Dated at Oneida, Wis., this 23rd day of August, 1976

Signature: Phillip T. Hansen Title: Registered Land Surveyor Registration No. 498 (County Surveyor, Registered Land Surveyor, or other duly authorized official)

Office of Register of Deeds, County of Oneida. I hereby certify that the within instrument was filed in this office for record on the 26th day of September, 1976 at 2:10 o'clock P.M.

Donna W. Kuehn (Register of Deeds)

By: Deputy

0308253030