


CERTIFIED LAND CORNER RESTORATION

Index No. **V-10**


State of Wisconsin }
 County of Oneida } ss.

I, Phillip T. Hansen, do hereby certify that on the 10th day of July, 1975, I found evidence of the W-1/16 corner of Sections 28 and 33 Township 36 North, Range 11 East, Fourth Principal Meridian, as described hereon; and that from this evidence I established a new monument and accessories as described hereon to perpetuate the original location of this corner.

Resident witnesses:

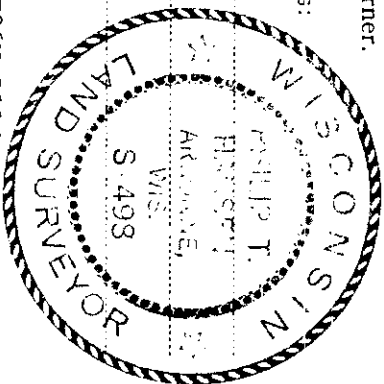

T36N R11E

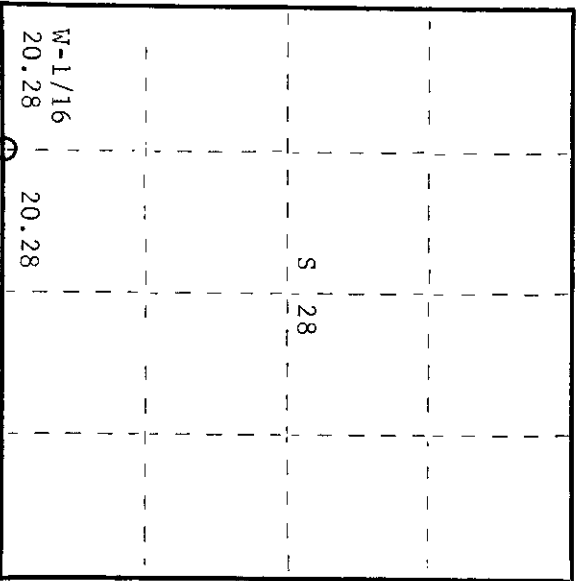

○ = Corner monument restored.

History of original corner establishment:

Corner established by H.C. Lawrence, Registered Land Surveyor, during retracement survey in 1955. From 1/4 corner in centerline of N-S town road, 39.96 chains south of centerline of U.S. Highway 8, an old fence line bears N84°E in hedgerow of rocks. He ran S85°W 40.56 chains, at which point section corner 28-29-32-33 is north at right angles 2.82 chains. Corrected line to S89°00'N and set 5" cedar post for W-1/16 corner 1.41 chains north at right angles, from 20.28 chains intermediate, from which maple 5" bears N40W 6 1/2 links, maple 8" bears N70°E 54 links, and maple 7" bears S81 1/2°E 48 links.

Description of corner evidence found:

Recovered 4" cedar post, squared and scribed W-1/16 S28, W-1/16 S33, in fair condition.

Recovered ORT's - red maple 5" (7") N40W 6.5 links Scribing grown over.

Red maple 8" (10") N70°E 54 links Scribed W-1/16 S28 BT.

Red maple 7" (9") S81 1/2°E 48 links Scribed S33 BT.

Description of monument and accessories I established to perpetuate the original location of this corner.
 Replaced 4" cedar post with 1 1/2" O.D. iron pipe with 2" brass cap stamped -

No additional accessories.

S498

T36N R11E

W-1/16 S | 28
 S | 33

CPT-1975

Dated at Rhinelanders Wis. this 24th day of July, 1975

Signature *Phillip T. Hansen* Title Registered Land Surveyor Registration No. S-498
 County Surveyor, Registered Land Surveyor, or other duly authorized official

Office of Register of Deeds, County of Oneida I hereby certify that the within instrument was filed in this office for record on the 1st day of October 1975 at 3:00 o'clock P.M.

Doris Senage Tucker
 (Register of Deeds)

By Deputy

3611280030