


CERTIFIED LAND CORNER RESTORATION

Index No. **2-3**


State of Wisconsin }
 County of Oneida } ss.

I Philip T. Hansen, do hereby certify that on the 12th day of August, 1975, I found evidence of the Quarter corner of Sections 6 and 31 Township 35 and 36, North, Range 11 East, Fourth Principal Meridian, as described hereon; and that from this evidence I established a new monument and accessories as described hereon to perpetuate the original location of this corner.

Resident witnesses:
 Glen Barker
 Jim Clafin

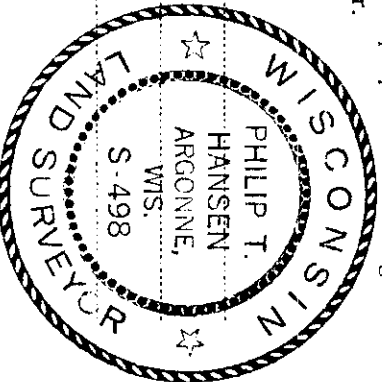

T36N R11E

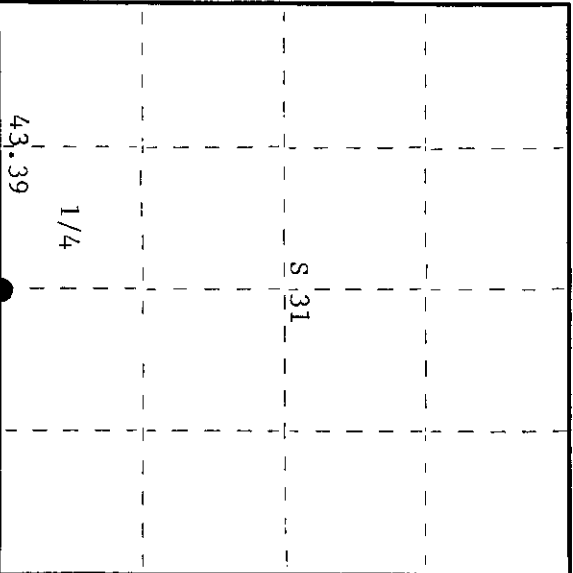

○ = Corner monument restored.

History of original corner establishment:

Original corner established by Hiram C. Fellows, Government Deputy Surveyor, in 1859 from which hemlock 7" bears S54°E, 24 links and tamarack 8" bears N89°W, 37 links. Corner re-established by H.C. Lawrence, Registered Land Surveyor, during his retracement survey in 1955. No evidence found of corner or bearing trees. Corner was set from existing fence lines and corners. Post was set at the intersection of the N-S fence and the center line of which is 33 ft. south. The N-S fence line is held by old settlers to be the N-S 1/4 line. Marked NBT's: White pine 18" bears S68°E, 72 links; maple 7" bears S8°E, 39 links; elm 7" bears N55°W, 59 links, fence post bears N100°W, 33 links.

Description of corner evidence found:

This corner sits in the center line of old Highway 26 South. No evidence was recovered of corner post. Original point determined by intersection of distance from Lawrence's BT. Recovered OBT's: Elm 7"(8") N55°W 59 links-scribing grown over
 Red maple 7"(8") S8°E 39 links-top scribing grown over, bottom scribed NBT
 White pine 18"(20") S68°E 72 links-scribed 1/4 S6 NBT

Description of monument and accessories I established to perpetuate the original location of this corner.
 Drove 1" x 18" iron pipe flush with ground for true corner.
 Set 2-1/2" iron pipe w/brass cap stamped -

No new BT's established.
 Measurements to old BT's are from true corner.

1/4 $\frac{S\ 31}{S\ 6}$ W.C.
 T35N R11E
 N50 links
 CPI-1975

Dated at Rhinelanders, Wis., this 5th day of September, 1975.

Signature *Philip T. Hansen* Title Registered Land Surveyor Registration No. S-498
 (County Surveyor, Registered Land Surveyor, or other duly authorized official)

Office of Register of Deeds, County of Oneida
 Instrument was filed in this office for record on the 14th day of October, 1975
 at 2:00 o'clock P.M.

Donna Savage Fischer
 (Register of Deeds)

By Deputy

3611310020