



CERTIFIED LAND CORNER RESTORATION

Index No. **2-11**

State of Wisconsin }  
 County of Oneida } ss.

I Philip T. Hansen do hereby certify that on the 3rd day of July, 1975, I found evidence of the Quarter corner of Sections 33 and 4 Township 36 and 35 North, Range 11 East, Fourth Principal Meridian, as described hereon; and that from this evidence I established a new monument and accessories as described hereon to perpetuate the original location of this corner.

Resident witnesses:

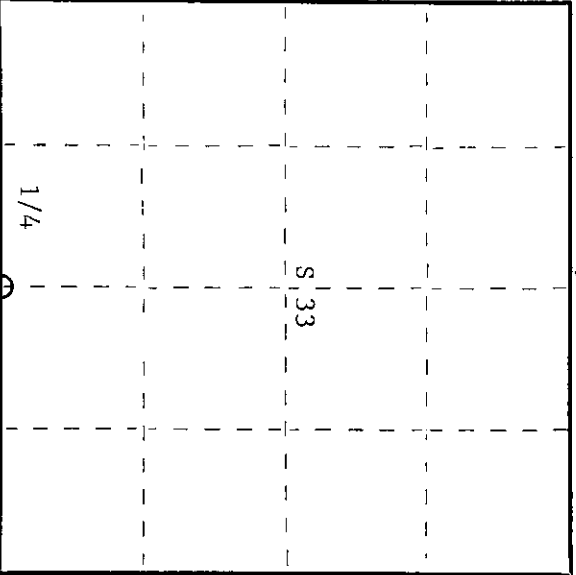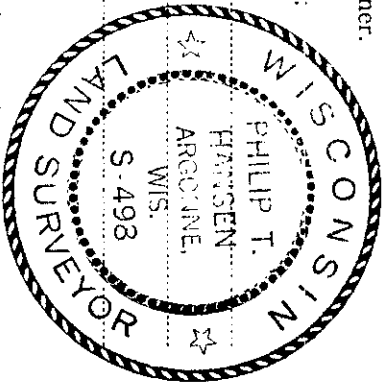

○ = Corner monument restored.

History of original corner establishment:  
 Original corner established by Hiram C. Fellows, Government Deputy Surveyor, in 1859 from which fir 12" bears N4°W, 6 links and white birch 12" bears S4°E, 23 links.  
 Corner restored by D.H. Vaughan, County Surveyor, in 1906. He ran West from S.E. corner set by B.F. Dorr, County Surveyor, from original notes 81.58 chains to a point 2.90 chains South of Southwest corner. He states a road 30' wide was cut out on this line 25 years before and the BT's at S-1/4 corner were obliterated. He set a new 1/4 post from which sugar maple 14" bears N4°W, 63 links and sugar maple 10" bears S45°W, 21 links.  
 Corner restored by H.C. Lawrence, Registered Land Surveyor, in 1953. Set a 5" cedar post on East side of road, 15 links offset from C/L road. No BT's were made.  
 Description of corner evidence found:  
 Recovered 5" cedar post, squared and scribed 1/4-S S4, T35N; 1/4-S R11E, S33, T36N; in fair condition. This is offset 15 links East of corner.  
 No OBT's were recovered.

Description of monument and accessories I established to perpetuate the original location of this corner:  
 Set a 2 1/2" iron pipe with brass cap 37 links East of true corner as there was now a seven foot cut in the roadbed and witness corner was in danger of falling down. The brass cap is stamped -  
 A 1 1/2" OD x 18" iron pipe was driven flush with the ground at the true corner, at C/L of town road. S498  
 T36N, R11E  
 NBT's - White pine 14" N28°E 94.5 links scribed 1/4 BT  
 White spruce 14" N82°E 27.6 links scribed 1/4 BT  
 Bearings and dist. measured to witness corner.  
 T35N, R11E  
 W37 links

Dated at Rhineland, Wis., this 23rd day of July, 1975.

Signature *Philip T. Hansen* Title Registered Land Surveyor Registration No. S-498  
 (County Surveyor, Registered Land Surveyor, or other duly authorized official)  
 Office of Register of Deeds, County of Oneida  
 Instrument was filed in this office for record on the 1st day of October, 1975  
 at 3:00 o'clock P.M.

*Doris Virginia Tucker*  
 (Register of Deeds)

By \_\_\_\_\_ Deputy

3611330020