

CERTIFIED LAND CORNER RESTORATION

Index No. **X-17**

State of Wisconsin

County of Oneida } ss.



I, Phillip T. Hansen, do hereby certify that on the 9th day of January, 1978, I found evidence of the Quarter corner of Section 34 & 35 Township 36 North, Range 11 East, Fourth Principal Meridian, as described hereon; and that from this evidence I established a new monument and accessories as described hereon to perpetuate the original location of this corner.

Resident witnesses:

Glen Barker

Jim Claflin

Herb Wagoner

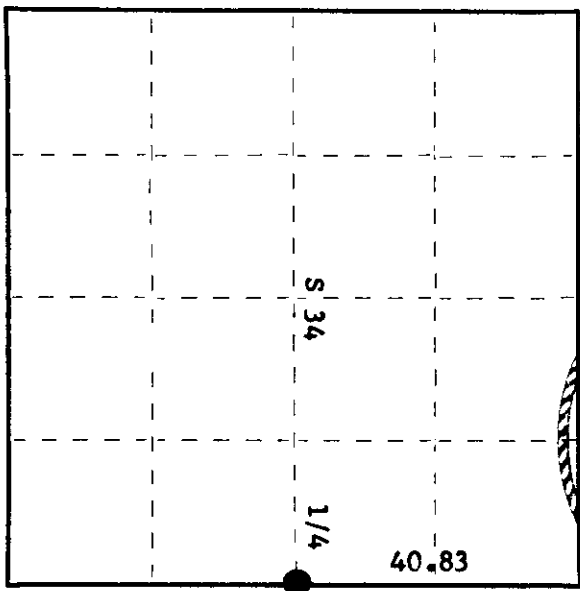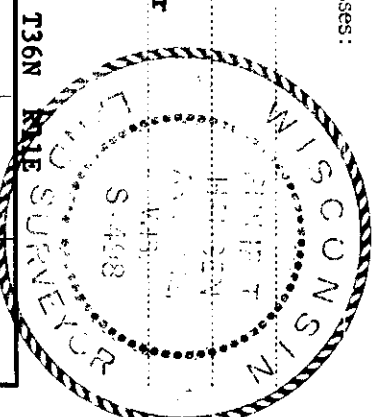

○ = Corner monument restored.

History of original corner establishment:

Original Corner established by Wm. E. Dougherty, Deputy Surveyor, in 1859, from which Sugar 10" bears N50°W, 21 links and Sugar 6" bears S74°E, 7 links. H.C. Lawrence, Registered Land Surveyor, ran random line S 9° E from Section Corner 26, 27, 34 & 35 in 1954. At 40.83 chains closed out 2.32 chains N85°W of old scribed 1/4 stake, believed to be B.F. Dorr's. No evidence of any BT's. No record in notes as to post set.

Description of corner evidence found:

Recovered 4" cedar post, squared and scribed 1/4S S34, 1/4S S35, with rock calrn around base. Also recovered a piece of an old square stake laying on calrn. No evidence of any BT's recovered.

Description of monument and accessories I established to perpetuate the original location of this corner.

Replaced H.C. Lawrence's wood post with 2 1/2" Berntsen A-1 Federal Monument projecting 18" above ground. Cap stamped:  
Replaced rock calrn around base.  
Marked NBT's - Sugar 7" S16°E, 17.7 links, S498  
Sugar 6" S87°E, 21.1 links, T36N  
Sugar 7" S80°W, 47.9 links, S35  
Red Oak 12" due north 25.6 links, 1/4  
all scribed 1/4 BT. R11E  
1978

Dated at Rhinelander, Wis., this 11th day of January, 1978

Signature Phillip T. Hansen Title Registered Land Surveyor Registration No. S-498  
(County Surveyor, Registered Land Surveyor, or other duly authorized official)

Office of Register of Deeds, County of Oneida I hereby certify that the within instrument was filed in this office for record on the 30th day of January, 1978 at 4:45 o'clock P. M.

Doree Venge Fuchler  
(Register of Deeds)

By \_\_\_\_\_ Deputy

3611242000