

CERTIFIED LAND CORNER RESTORATION

Index No. X-15

State of Wisconsin
County of Oneida

ss. Daniel K. Pleoeger

I Daniel K. Pleoeger, do hereby certify that on the 20th day of November, 1981, I ~~restored~~ restored


Est ~~existence~~ of the C 1/4

corner of Section 34

Township 36, North, Range 11, East, Fourth Principal Meridian,

as described hereon; and that from this evidence I established a new monument and accessories as described hereon to perpetuate the original location of this corner.

Resident witnesses

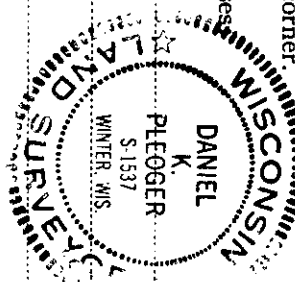

T36N R11E

History of original corner establishment:
No evidence of any previous corner.

Description of corner evidence found:
Corner established by subdivision of Sec. 34.
Corner sets S4-45-28W 2499.32 ft. of north 1/4 corner and N81-40-52W 2814.688 ft. of E 1/4 corner.
N4-45-28E 2300.236 ft. of S 1/4 corner
S81-40-52E 2921.077 ft. of W 1/4 corner.

Description of monument and accessories I established to perpetuate the original location of this corner.
Set a 2 1/2" aluminum pipe with alloy cap stamped:

Monument projects 12" above ground. T36N R11E
Marked NBTs: C 1/4 S134
Maple 6" S4°W 27.00 ft. S1537 - 1981
White ash 8" N28W 24.50 ft.
Sugar 6" S51E 31.87 ft.
Scribed C1/4 - B.T.


Dated at Rhinelander, Wis., this 8th day of January, 1982

Signature: *David K. Pleoeger* Title: Registered Land Surveyor Registration No. 1537
(County Surveyor, Registered Land Surveyor, or other duly authorized official)

Office of Registrar of Deeds, County of Oneida, I hereby certify that the within instrument was filed in this office for record on the 24th day of March, 1982 at 11:55 o'clock A.M.

Louis George Tuckman
(Registrar of Deeds)

○ = Corner monument restored.

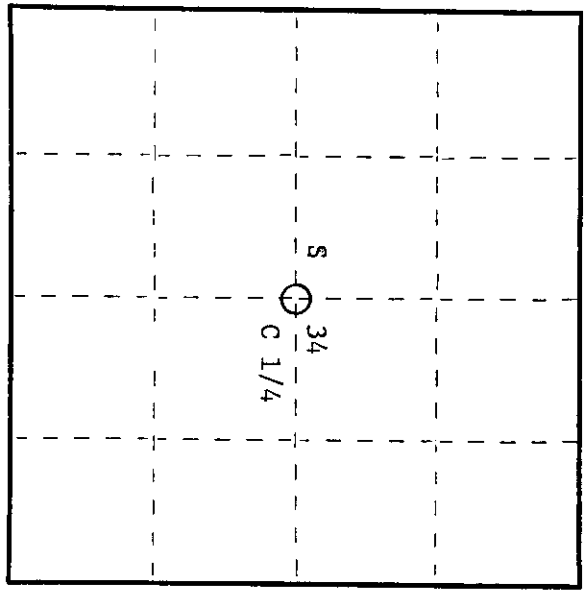

3611342020