

CERTIFIED LAND CORNER RESTORATION

Index No. W - 15


State of Wisconsin } ss.
County of Oneida

History of original corner establishment:
No evidence of any previous corner.

I Daniel K. Pleoeger, do hereby certify that on the 31 day of December 19 81, I found evidence of the NC 1/16 Section 34 corner of Township 36 North, Range 11 East, Fourth Principal Meridian, as described hereon; and that from this evidence I established a new monument and accessories as described hereon to perpetuate the original location of this corner.

Description of corner evidence found:
Total distance from 1/4 corner between sections 27 & 34 to C 1/4 corner section 34 is 2499.32 ft. at bearing S4-45-28W. Set NC 1/16 1249.66 ft. intermediate.

Resident witnesses:

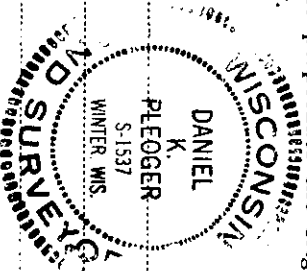


T36N R11E

Description of monument and accessories I established to perpetuate the original location of this corner.
Set a 1 1/2" iron pipe with 2" diameter aluminum cap stamped:
Monument projects 18" above ground. S1537
Marked NBTs: T36N R11E

Sugar 5" N83E 11.76 ft.
Black ash 6" S26W 9.34 ft.
Scribed 1/16 BT

NC 1/16 S | 34
CPI - 1981

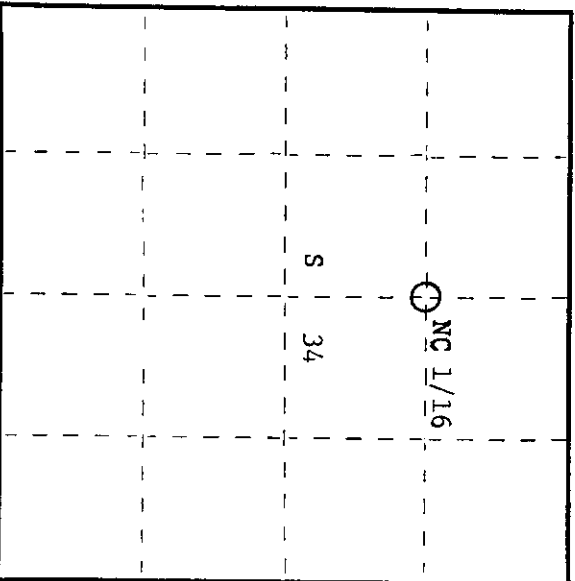

O = Corner monument restored.

Dated at Rhinelander, Wis., this 8th day of January, 19 82.

Signature: *Daniel K. Pleoeger* Title: Registered Land Surveyor Registration No. 1537
(County Surveyor/Registered Land Surveyor, or other duly authorized official)

Office of Register of Deeds, County of Oneida, I hereby certify that the within instrument was filed in this office for record on the 24th day of March, 19 82 at 10:35 o'clock A.M.

Doris Savage Fuchs
(Register of Deeds)

By: Deputy

3611343020