


US PUBLIC LAND SURVEY MONUMENT RECORD

Per Wis. Admin. Code § A-E 7.08, a U.S. public land survey monument record shall be prepared and filed with the county survey records as part of any land survey within 60 days of setting or accepting the corner, which includes or requires the perpetuation, restoration, or use of a U.S. public land survey corner and when any of the situations in Wis. Admin. Code § A-E 7.08(1)(a), (b) or (c) arise.

3(a) Corner Identification:
 Found brass cap
 Meander Corner-west shore of Snowden Lake
 Section 30
 Township 37 North
 Range 10 East
 4th Principal Meridian
 Town of Stella
 Oneida Co., WI

Observed Coordinates:
 N: 172269.54
 E: 296648.16
 Datum: NAD83(2011)
 GNSS Control: WISCRS NETWORK
 GNSS Method: RTK-Direct
 Verification Method: 2

CORNER ID:
3710300001

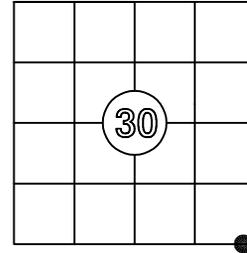

Establishment of Original Corner



Corner Set: wood post
 Original Surveyor: Wm. Daugherty
 Date of Survey: June 1863
 Birch 10", N 49° W, 14 lks
 Birch 10", S 48° W, 8 lks

The coordinate value has been verified by at least one of the following methods:

1. Comparison to a previously determined GNSS determined published value;
2. The value is the average of two or more GNSS observations at markedly different times;
3. One or more distances were measured to the corner from offset GNSS observed locations, set and observed per No. 2 methods.

3(b)(c)(d)(f)(g)(h)

- 12/13/1912 - D.H. Vaughn's notes state that he was at this location and set a post on the west shore of Stone (now Snowden) Lake.
- 4/30/1949 - N.M. Rowinski finds MC post and iron pipe.
- 8/17/1953 - Hugh B. Crawford, Cadastral Engineer, B.L.M. executes a dependent resurvey of Sections 29 and 30. He set an iron post with a 2 1/2" brass cap stamped to mark the location. His notes state that he found Vaughn's iron pipe 0.12 chains west of this location. He established two witnesses, a maple 11", S 35° W, 27 lks (now a rotten stump) and a white pine 12", N 22° W, 66 lks, (now a dead 30' tall stub).
- 7/29/1976 - Harold Behn, S-1221, finds the B.L.M. monument and Crawford's witnesses. He also found Vaughn's iron pipe.
- 5/23/1977 - James Rein, S-1234 finds the B.L.M. monument.
- 10/25/2025 - I, Anthony Jones, S-2508, found Crawford's brass B.L.M. disk in good condition on a walking path, flush with the ground and stamped to show the location. I also found Vaughn's 1 1/2" (2" o.d.) iron pipe. As neither of Crawford's ties are viable, I made five new witnesses, as shown below. I set a white, plastic guard post next to Vaughn's pipe.

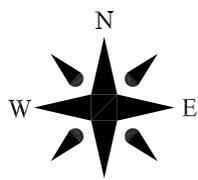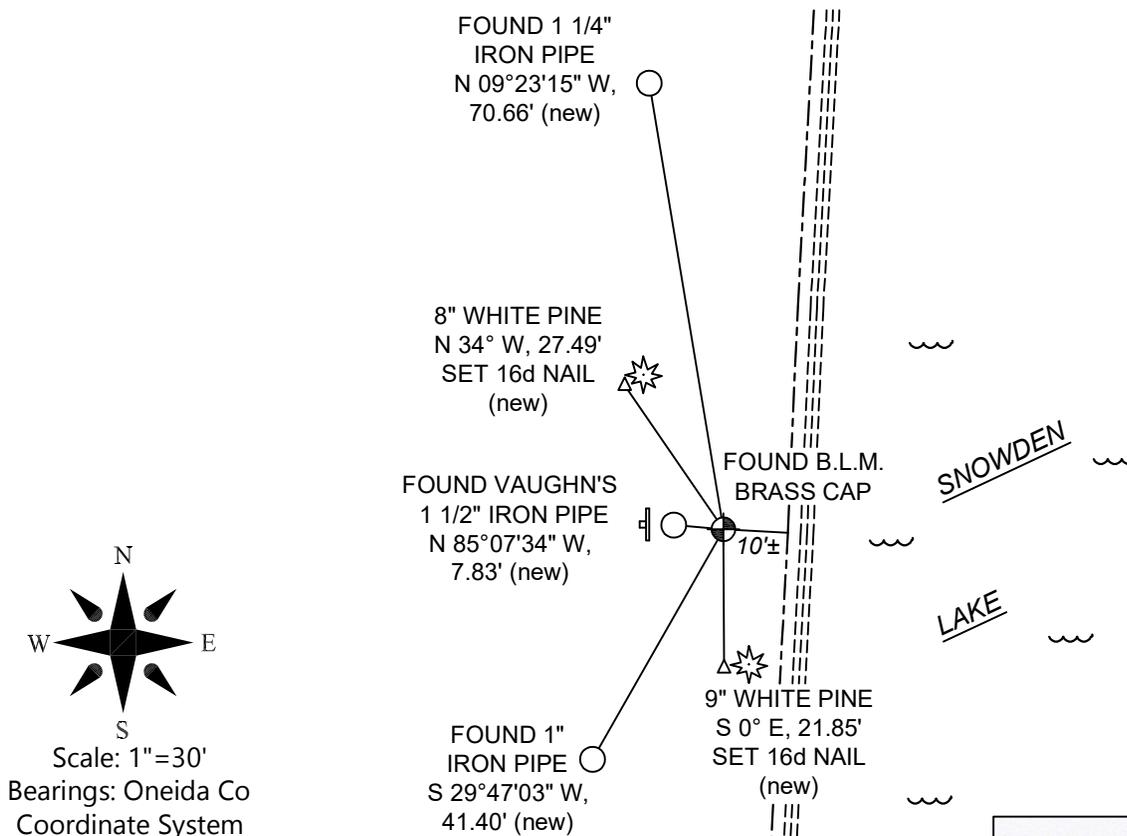

Scale: 1"=30'
 Bearings: Oneida Co
 Coordinate System

3(i) I, Anthony R. Jones, Wisconsin Professional Land Surveyor No S-2508, hereby certify that the corner location shown on this record was determined by me, and that this U.S. Public Land Survey Monument Record is correct and complete to the best of my knowledge and belief.

