

U.S. PUBLIC LAND SURVEY MONUMENT RECORD


Note: This form is intended and designed to fulfill all requirements of the Wisconsin Administrative Code, Chapter A-E 7.08 U.S. Public Land MonumentRecord (3)(a)(b)(c)(d)(e)(f)(g)(h)(i). An additional sheet may be added if necessary to conform with said requirements.

(a) CORNER LOCATION: WISCRS - Onedia County
Meander Corner of Section 9 North: 219953.032 USft
Township 38 North East: 242607.142 USft
Range 8 East Datum: NAD 83(2011) ep. 2010.00
Town of Newbold GNSS Method: RTN - Direct
County of Oneida GNSS Control: WISCRS VRS

Oneida County
Land Information Office
Filed
5/18/2026

(RECORDING AREA)

SECTION 9

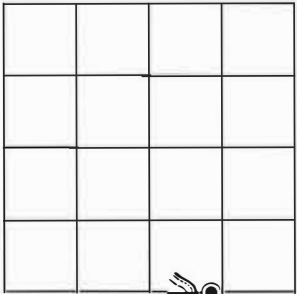

(b) HISTORY OF ORIGINAL CORNER ESTABLISHMENT

Original Surveyor: Alex Anderson, Deputy Surveyor
Date of Survey: July 10, 1863
July 21, 1863
Original B.T.'S: Birch, S 8°E, 10 links
W. Pine, N 6°1'W, 15 links

(f)(g)(h) DESCRIPTION OF MONUMENT FOUND AT THIS CORNER AND IF IT WAS ACCEPTED, STATE ALL EVIDENCE (MATERIAL, TESTIMONIAL, OCCUPATIONAL, PLATS, RECORD, OTHER MONUMENTS) USED AS A BASIS FOR ESTABLISHING LOCATION. IF NOT ACCEPTED OR IF NOTHING WAS FOUND, STATE EVIDENCE USED AS BASIS FOR ESTABLISHING LOCATION. IF REESTABLISHED THROUGH LOST CORNER PROPORTIONATE METHODS, INDICATE ALL MONUMENTS, DISTANCES AND DIRECTIONS USED TO ESTABLISH. INDICATE TYPE OF MONUMENT AND SIGN POST FOUND OR SET.

Undated map filed as L1397 in the Oneida County Surveyor's Office depicts the meander corner on the easterly shore of Long Lake, 1591.92 feet west of the section corner.


May 17, 2000. William E. Badow, PLS-1182, on Genisot and Associates, Inc. Drawing 9940, filed as map C1717 in the Oneda County Surveyor's Office, legends meander corner monumented by a found 1" iron pipe located 1575.56 feet westerly of the section corner.

June 28, 2010, James D. Rein, PLS-1234, Wilderness Surveying, Inc. Map No. 10-72-2, filed as B7351 in the Oneida County Surveyor's Office describes the corner monumented by a recovered 1.0" dia. iron pipe located 1575.22 feet westerly of the section corner, and it was replaced by an Oneida County, capped, 2.4" dia. aluminum monument. Field notes show new references: Set alum. nail in 5" blazed r. pine, N 19°W, 8.68'; set alum. nail in 7" blazed r. pine, North, 17.09'; set alum. nail in 20" blazed r. pine, N 67°E, 11.14'; set alum. nail in 22" blazed r. pine, S 62°E, 20.31'.

August 27, 2028, James D. Rein, PLS No. S-1234, we found and I accepted the Oneida County, capped 2.4" dia. aluminum monument we previously set. We further perpetuate it as shown in the plan. See below for updated ties to our previous references.

The coordinate value shown has been verified by our prior offset traverse tie to this corner.

(c)(d)(e) PLAN VIEW OF CORNER WITH TIES TO AT LEAST 4 WITNESS MONUMENTS. IF IN DISAGREEMENT WITH PREVIOUSLY ESTABLISHED CORNER, SHOW THE DISTANCE BETWEEN THE TWO CORNERS AND ALSO INDICATE THE TIES TO THE DISPUTED CORNER.

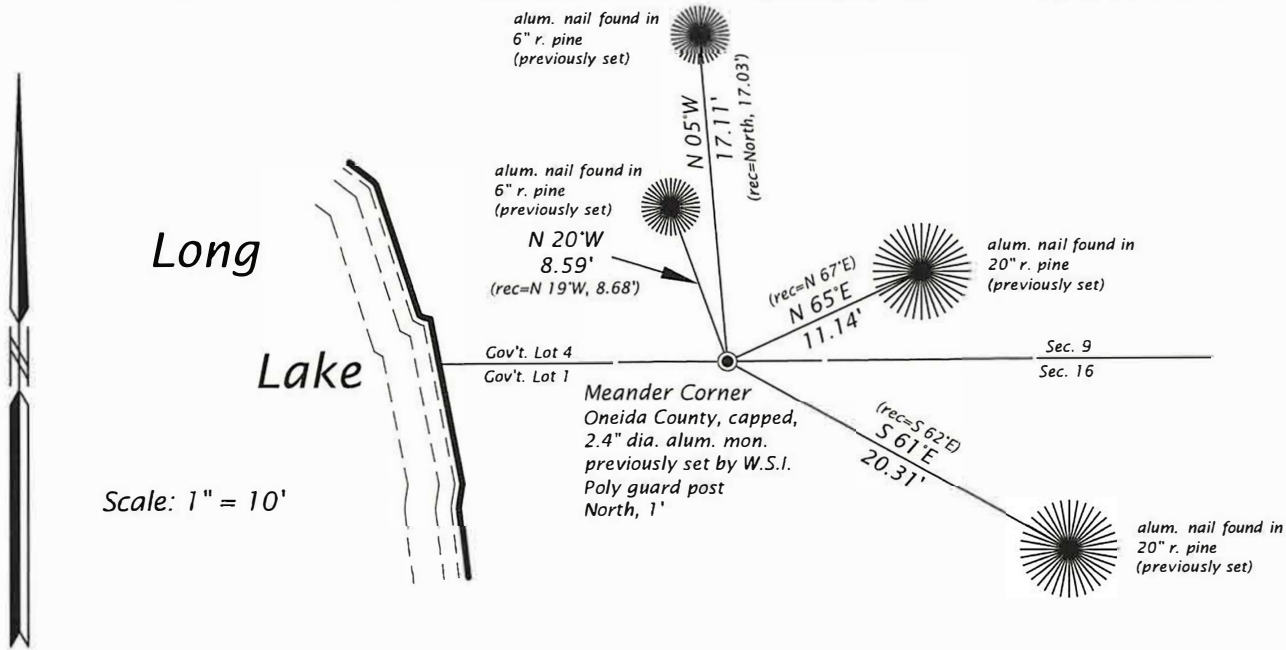

(i) I, JAMES D. REIN, PROFESSIONAL LAND SURVEYOR NO. S-1234 HEREBY CERTIFY THAT THE CORNER LOCATION ON THIS RECORD WAS DETERMINED BY ME OR UNDER MY DIRECTION AND CONTROL AND THAT THIS U.S. PUBLIC LAND SURVEY MONUMENT RECORD IS CORRECT AND COMPLETE TO THE BEST OF MY KNOWLEDGE AND BELIEF

SIGNATURE James D. Rein DATE 4/02/26



INDEX NO. J - 26-27
3808090011