U.S. PUBLIC LAND SURVEY MONUMENT RECORD


Note: This form is intended and designed to fulfill all requirements of Wisconsin Administrative Code, Chapter A-E 7.08 U.S Public Land Survey Monument Record (3) (a) (b) (c) (d) (e) (f) (g) (h) (i). An additional sheet may be added if necessary to conform with said requirements.

(a) Corner location: Township 38 North

Range 9 East/West

Town/City/Village Sugar Camp

County Oneida

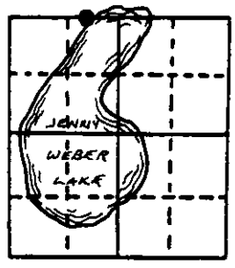

Section 35


(b) (f) (g) (h) Description of monument found at this corner and if it was accepted, state all evidence (material, testimonial, occupational, plats, records, other monuments) used as a basis for accepting. If not accepted or if nothing was found, state evidence used as basis for establishing location. If reestablished through lost corner proportionate methods, indicate all monuments, distances and directions used to establish. Indicate type of monument found or set and sign post.


September, 1863 - Wm. E. Daugherty set meander post and made B.T. - Fir 10", N 55° W,20 lks, Fir 12", S 73° W, 35 lks.

October, 1959 - (Per recorded survey and field notes.) Hugh B. Crawford (B.L.M.) in retracement of section 35, found a 1/2" iron pipe for the meander corner.. He set a 2.5" brass capped iron pipe and made the following b.t.'s - 12" Pine , S 79-3/4° W, 55-1/2 lks, 10" Pine, N 51-3/4° W, 33-1/2 lks, blazed and scribed He measured 27.97 ch.(1846.02') West to the NW section corner.

December, 2000 - I found Crawford's bras capped, scribed, iron pipe lying down on the lake bottom of Jenny Weber lake 1' from eroded bank. I also found his two live b.t.'s. I rest Crawford's corner with a nail on the ice by measuring his record ties from blazes on his b.t.'s and measured 1844.55' from the (over)

(c) (d) (e) Plan view of corner with ties to at least 4 witness monuments. If in disagreement with previously established corner, show the distances between the two corners and also indicate the ties to the disputed corner.

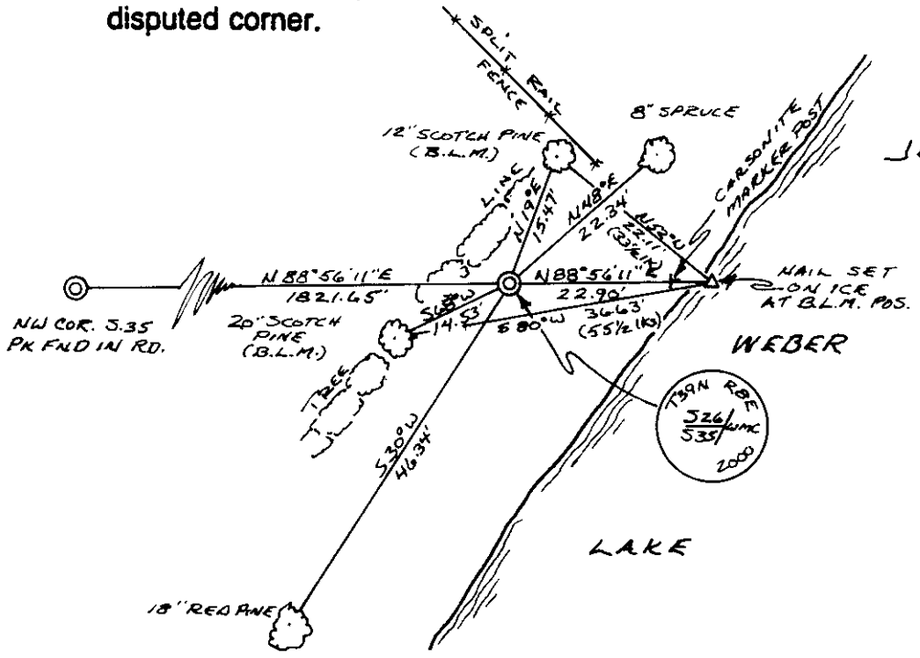

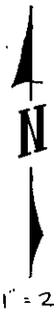

1" = 20'

COURSES MEAS'D TO B.L.M. POS. ARE FROM THE BLAZED FACE OF THEIR EXISTING B.T.'S. COURSES MEAS'D TO W.M.C. SET ARE FROM NAILS SET IN SIDES OF EACH B.T.

SET ONEIDA CO. ALUM. MON FOR W.M.C. JUST BELOW GRADE IN LAWN. STAMPED AS ~~S 1000~~.

(i) I, Keith A. Zarm RLS - 2425 (type or print name) certify that the corner location on this record was determined by me or under my direction and control and that this U.S. Public Land Survey Monument Record is correct and complete to the best of my knowledge and belief.

Signature

24 AUG 01

Date

WISCONSIN KEITH A. ZARM S-2425 RHINELANDER WI LAND SURVEYOR


3809260027

Stamp

Index No. V-18-19

Continued

NW Section Corner. I then set a Witness Meander Corner on the section line on solid ground and made two additional b.t.'s and set nails in sides of crawford's b.t.'s-all witnessing the new w.m.c. as shown below.

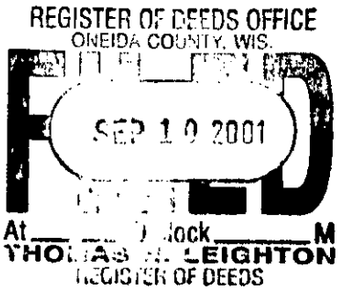

Oneida County
Land Information Office
Filed
8/26/2026

US PUBLIC LAND SURVEY MONUMENT RECORD

Per Wis. Admin. Code § A-E 7.08, a U.S. public land survey monument record shall be prepared and filed with the county survey records as part of any land survey within 60 days of setting or accepting the corner, which includes or requires the perpetuation, restoration, or use of a U.S. public land survey corner and when any of the situations in Wis. Admin. Code § A-E 7.08(1)(a), (b) or (c) arise.


3(a) Corner Identification:

Found aluminum Oneida Co monument
Witness Corner to the Meander Corner
Section 26
Township 38 North
Range 9 East
4th Principal Meridian
Town of Sugar Camp
Oneida Co., WI

History of Original Corner Establishment
Corner Set: Wood Post
Original Surveyor: Wm. Daugherty
Date of Survey: September,1863
Fir, 10" N 55° W, 20 links
Fir, 12" S 73° W, 35 links

Observed Coordinates:
N: 204674.91
E: 284634.24
Datum: NAD 83(2011)
GNSS Control: WISCRS Network
GNSS Method: RTK-Direct
Verification Method: 2

The coordinate value has been verified by at least one of the following methods: 1) comparison to a previously GNSS determined published value; 2) The value is the average of two or more GNSS observations at markedly different times; 3) one or more distances were measured to the corner from temporary GNSS observed offest locations.

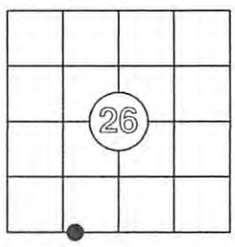

CORNER ID:
3809260027

3(b)((c)(d)(f)(g)(h)


This is a continuation of a previous USPLSS Monument Record by Surveyor Keith Zarm (2001). See previous record for additional history on this corner.

- 8/24/2001 - Keith Zarm, S-2425, set an Oneida County aluminum monument as a witness corner to the meander corner, which he noted as a found BLM monument in Jenny Weber Lake.
- 10/06/2004 - Kip Soder, S-1731, finds the Oneida County aluminum monument.
- 4/27/2010 - Russ Brown, S-2148, finds the Oneida County aluminum monument.
- 8/1/2026 - I, Anthony Jones, S-2508, found the Oneida County aluminum monument, set by Zarm, in good condition, stamped to identify the location, as shown on Zarm's record. I also found all of Zarm's witness trees/nails as described. See updated tie information below. I did not set a white witness post as this location is in a manicured front yard.

WITNESS MONUMENT TIES

1. 23" red pine (found): S 30° W, 46.38'. Zarm's nail is grown over. I set a new nail in the west side of the tree. The BLM blaze has grown over.
2. 24" Scotch pine (found): S 60° W, 14.26'. Zarm's nail is grown over. I set a new nail in the north side of the tree. The BLM blaze has grown over.
3. 14" Scotch pine (found): N 19° E, 15.51'. Zarm's nail is in good condition. The BLM blaze is open.
4. 10" spruce (found): N 48° E 22.50'. Zarm's nail is in good condition.

WITNESS CORNER TO THE MEANDER CORNER
SECTION 26-38-09
FOUND 2 1/2" ONEIDA COUNTY ALUMINUM MONUMENT

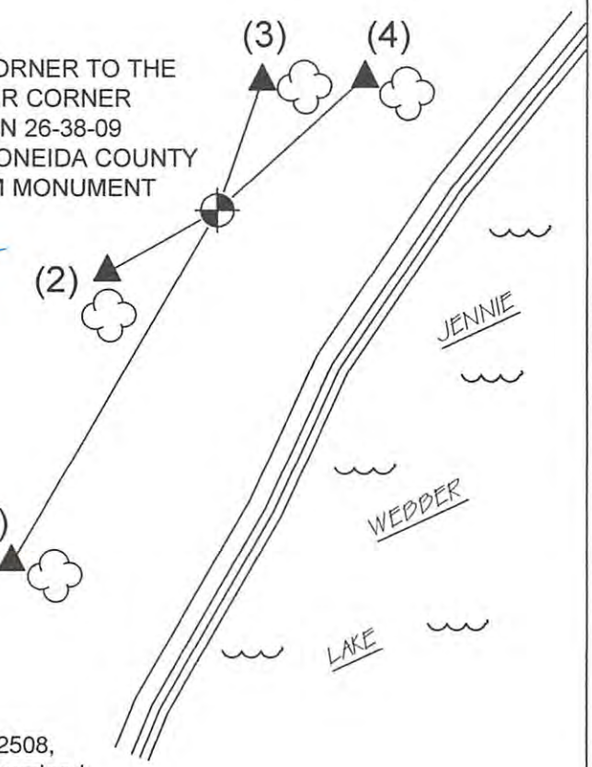





Bearings: Magnetic
Not to scale

3(i)

I, Anthony R. Jones, Wisconsin Professional Land Surveyor No S-2508, hereby certify that the corner location shown on this record was determined by me, or under my direction or control, and that this U.S. Public Land Survey Monument Record is correct and complete to the best of my knowledge and belief.