


U.S. PUBLIC LAND SURVEY MONUMENT RECORD

Note: This form is intended and designed to fulfill all requirements of the Wisconsin Administrative Code, Chapter A-E 7.08 U.S. Public Land MonumentRecord (3)(a)(b)(c)(d)(e)(f)(g)(h)(i). An additional sheet may be added if necessary to conform with said requirements.

Oneida County
Land Information Office
Filed
6/22/2026

(a) CORNER LOCATION: WISCRS - Oneida County
Meander Corner of Section 34 North:
Township 39 North East:
Range 6 East Datum:
Town of Minocqua GNSS Method:
County of Oneida GNSS Control:

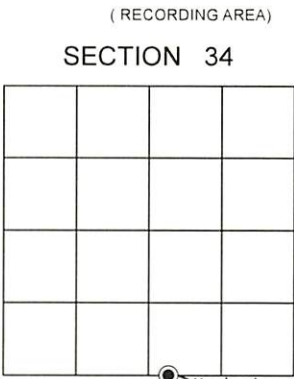


(b) HISTORY OF ORIGINAL CORNER ESTABLISHMENT
Original Surveyor: Alford Millard
Date of Survey: Commenced August 8, 1860
Completed September 19, 1860
Original B.T.'S Aspen 9" S 89°W, 147 links (97.02 feet)

(f)(g)(h) DESCRIPTION OF MONUMENT FOUND AT THIS CORNER AND IF IT WAS ACCEPTED, STATE ALL EVIDENCE (MATERIAL, TESTIMONIAL, OCCUPATIONAL, PLATS, RECORD, OTHER MONUMENTS) USED AS A BASIS FOR ESTABLISHING LOCATION. IF NOT ACCEPTED OR IF NOTHING WAS FOUND, STATE EVIDENCE USED AS BASIS FOR ESTABLISHING LOCATION. IF REESTABLISHED THROUGH LOST CORNER PROPORTIONATE METHODS, INDICATE ALL MONUMENTS, DISTANCES AND DIRECTIONS USED TO ESTABLISH. INDICATE TYPE OF MONUMENT AND SIGN POST FOUND OR SET.


May 2, 1924 - Recorded Plat of Sylvan Shores - A. L. Deleghise, Surveyor describes the corner monumented by a 2" x 24" iron
December 28 - 29, 1953 - E. F. Kowalke, Surveyor - Field Book 12, describes corner monumented by post & I.P., witnessed by a W. Pine 16" N 42°E, 49'
October ?, 1975 - Stuart Foltz, Surveyor - Fisher, Inman, Foltz and Associates map filed as B610 describes corner monumented by 1" iron pipe, witnessed by a 24" W. Pine bearing N 50°E, 40.0 feet.
April 8, 2025 - James D. Rein, PLS No. 1234, we replaced a found broken 1.5" dia. iron pipe with a stamped Oneida County aluminum capped 1" dia. x 60" long aluminum monument in wetland area. Made reference ties to the corner as shown below in plan.

(c)(d)(e) PLAN VIEW OF CORNER WITH TIES TO AT LEAST 4 WITNESS MONUMENTS. IF IN DISAGREEMENT WITH PREVIOUSLY ESTABLISHED CORNER, SHOW THE DISTANCE BETWEEN THE TWO CORNERS AND ALSO INDICATE THE TIES TO THE DISPUTED CORNER.

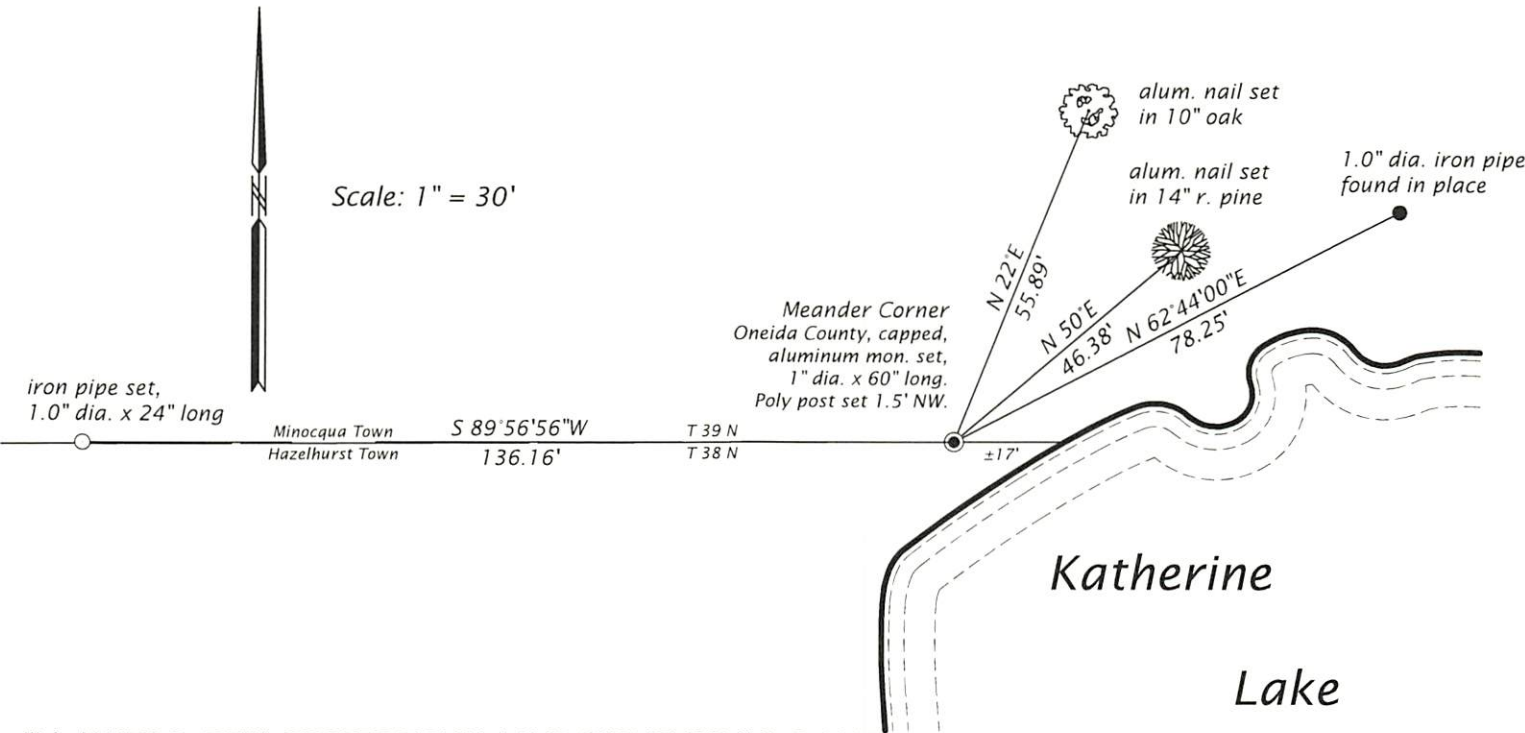

(i) I, JAMES D. REIN, PROFESSIONAL LAND SURVEYOR NO. S-1234 HEREBY CERTIFY THAT THE CORNER LOCATION ON THIS RECORD WAS DETERMINED BY ME OR UNDER MY DIRECTION AND CONTROL AND THAT THIS U.S. PUBLIC LAND SURVEY MONUMENT RECORD IS CORRECT AND COMPLETE TO THE BEST OF MY KNOWLEDGE AND BELIEF.

SIGNATURE *James D. Rein* DATE *12/27/25*

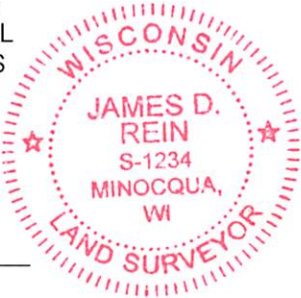

INDEX NO. 3906340018